

MISSISSIPPI DEPARTMENT OF NATURAL RESOURCES

Bureau of Land and Water Resources

Southport Mall

P.O. Box 10631

Jackson, Mississippi 39209

WATER WELL DRILLERS LOG

P. River  
V. 2500

8/30  
date well completed

1988 Bud Denton  
firm name

pearl river  
county well located

LANDOWNER: Queen Kelley  
R.T. 2 Carrier m.s.  
(mailing address)

description of formations encountered

from to

Red shale	0	10
white sand	10	30
Blue shale	30	187
Blue sand	187	263

WELL LOCATION:

sec. 34 T. 5 N. R. 16 E  
S. W.  
3 miles East of Carrier  
(distance) (direction) (nearest town)

WELL PURPOSE: home  
(home, irrigation, municipal, industrial)

WELL COMPLETION DATA:

- (1) diameter (inches) 2'
- (2) total depth (feet) 263
- (3) static water level (feet) 8 below/above top of ground.
- (4) casing pvc 263  
(material) (depth)
- (size) if telescope see back.
- (5) screen 10 25.3  
(length) (depth to top)
- 12 pvc  
(size) (material)
- (6) pump 1/2 420  
(HP) (yield gpm)
- Elect  
(type power)
- (7) electric log no  
(yes or no)

(organization running log)

(8) how well bottom plugged Sand  
sharp

DRILLERS REMARKS:




NOV 15 1988

Department of Natural Resources  
Bureau of Land & Water Resources

If well telescopes please sketch and show depths.

GROUND LEVEL

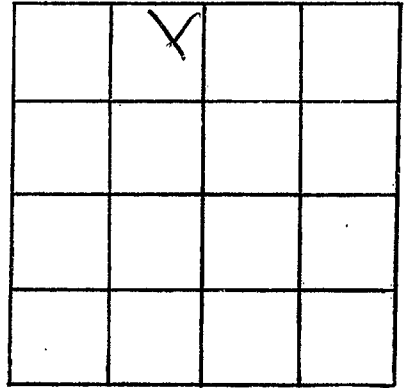

SECTION 34

Please indicate well location X.

ADDITIONAL INFORMATION

If more than one screen,  
show locations of each on sketch.