

MISSISSIPPI DEPARTMENT OF NATURAL RESOURCES

Bureau of Land and Water Resources

Southport Mall

P.O. Box 10631

Jackson, Mississippi 39209

WATER WELL DRILLERS LOG

P. RIVER
V 2102

5/13 1989 Bud Penton Pearl River
date well completed firm name county well located

LANDOWNER: <u>Edith Dickson</u>	description of formations encountered	from	to
<u>R.T-4 Box Carrier</u>	<u>White shell</u>	<u>0</u>	<u>237</u>
	<u>Blue sand no gravel</u>	<u>237</u>	<u>244</u>
	<u>Blue shale</u>	<u>244</u>	<u>275</u>
	<u>Blue sand no gravel</u>	<u>275</u>	<u>294</u>
	<u>Blue shale</u>	<u>294</u>	<u>310</u>
	<u>Gray sand</u>	<u>310</u>	<u>400</u>


WELL LOCATION:
sec. 23 T 5 N R. 16 E
S W
8 miles East of Carrier
(distance) (direction) (nearest town)

WELL PURPOSE: home
(home, irrigation, municipal, industrial)

- WELL COMPLETION DATA:
- (1) diameter (inches) 4"
 - (2) total depth (feet) 400
 - (3) static water level (feet) 40 below top of ground.
 - (4) casing PCO, 400,
(material) (depth)
 - 4 1/2" If telescope see back.
(size)
 - (5) screen 10, 390
(length) (depth to top)
 - 12, PCO
(size) (material)
 - (6) pump 1/2, 10
(HP) (yield gpm)
 - Elect
(type power)
 - (7) electric log no
(yes or no)

(organization running log)
(8) how well bottom plugged sharp

DRILLERS REMARKS:

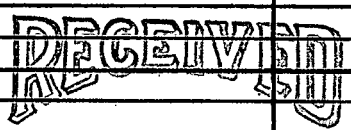


MAY 24 1989

Department of Natural Resources
Bureau of Land & Water Resources

If well telescopes please sketch and show depths.

GROUND LEVEL

240ft. 2"
160ft. 4"

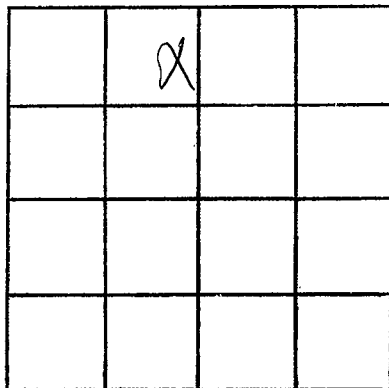

SECTION _____

Please indicate well location X.

ADDITIONAL INFORMATION

If more than one screen, show locations of each on sketch.