

MISSISSIPPI DEPARTMENT OF NATURAL RESOURCES

Bureau of Land and Water Resources

Southport Mall

P.O. Box 10631

Jackson, Mississippi 39209

WATER WELL DRILLERS LOG

P. RIVER
V 2013

1/4 1991 date well completed 91 Bedpe, Tex. well near PEARL RIVER firm name county well located

LANDOWNER: Bob & Cyndee  
Sycamore Rd  
Pearl (mailing address)

description of formations encountered	from	to
Red shale	0	16
White sand	16	35
Blue shale	35	190
Blue sand	190	292

WELL LOCATION:  
 sec 25 T 5 N R 16 E  
1 miles East of Pearl  
 (distance) (direction) (nearest town)

WELL PURPOSE: home  
 (home, irrigation, municipal, industrial)

- WELL COMPLETION DATA:
- (1) diameter (inches) 2"
  - (2) total depth (feet) 292
  - (3) static water level (feet) 42 below above top of ground.
  - (4) casing pvc, 292,  
 (material) (depth)  
 (size) If telescope see back.
  - (5) screen 10, 282  
 (length) (depth to top)  
12, pvc  
 (size) (material)
  - (6) pump 1 (HP)   (yield gpm)  
Elect  
 (type power)
  - (7) electric log no  
 (yes or no)  
 (organization running log)
  - (8) how well bottom plugged


RECEIVED  
 JUN 7 1991

Dept. of Environmental Quality  
 Bureau of Land & Water Resources

DRILLERS REMARKS:

If well telescopes please sketch and show depths.

GROUND LEVEL

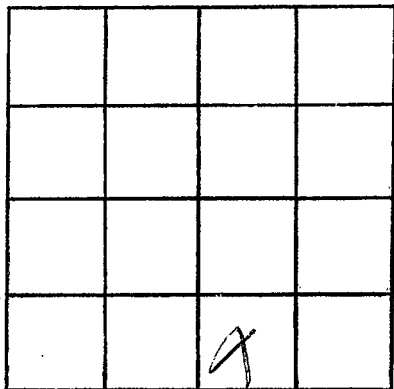

SECTION \_\_\_\_\_

Please indicate well location X.

ADDITIONAL INFORMATION

If more than one screen,  
show locations of each on sketch.