

MISSISSIPPI DEPARTMENT OF NATURAL RESOURCES

Bureau of Land and Water Resources

Southport Mall

P.O. Box 10631

Jackson, Mississippi 39209

WATER WELL DRILLERS LOG

Pearl River
Vadis

5/13 1992 Badgerman Pearl River
 (date well completed) (firm name) (county well located)


LANDOWNER: Jeff Wheat
R.T. 2 Box 347 A
Carrier Miss. 39426
 (mailing address)

description of formations encountered	from	to
<u>White shale</u>	<u>0</u>	<u>350</u>
<u>gray sand</u>	<u>350</u>	<u>380</u>

WELL LOCATION:
 sec. 15 T 5 N R. 16 E
8 miles East of Carrier
 (distance) (direction) (nearest town)

WELL PURPOSE: home
 (home, irrigation, municipal, industrial)

- WELL COMPLETION DATA:
- (1) diameter (inches) 2"
 - (2) total depth (feet) 380
 - (3) static water level (feet) 5-8 below above top of ground.
 - (4) casing pvc, 380,
 (material) (depth)
 (size) if telescope see back.
 - (5) screen 10, 370
 (length) (depth to top)
12, pvc
 (size) (material)
 - (6) pump 1 12
 (HP) (yield gpm)
Elect
 (type power)
 - (7) electric log NO
 (yes or no)

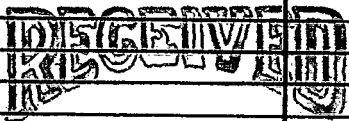

JUN 08 1992


Dept. of Environmental Quality
 Bureau of Land & Water Resources

(organization running log)
 (8) how well bottom plugged hard
shark

DRILLERS REMARKS:

If well telescopes please sketch and show depths.

GROUND LEVEL

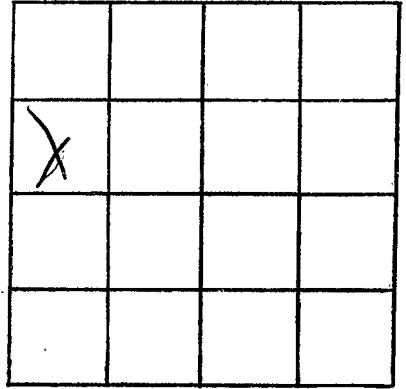

SECTION _____

Please indicate well location X.

ADDITIONAL INFORMATION

If more than one screen,
show locations of each on sketch.