

MISSISSIPPI DEPARTMENT OF NATURAL RESOURCES

Bureau of Land and Water Resources

Southport Mall

P.O. Box 10631

Jackson, Mississippi 39209

WATER WELL DRILLERS LOG

Pearl River  
 ✓ 2016

573  
 date well completed

1992 Bud Denton + Jan Pearl River  
 firm name county well located

LANDOWNER: Glen Bond  
R.T. 2 Box 348 C  
Carrier Miss  
 (mailing address)

WELL LOCATION:  
 sec. 15 T. 5 N R. 16 E  
6 miles East of Carrier  
 (distance) (direction) (nearest town)

WELL PURPOSE: home  
 (home, irrigation, municipal, industrial)

WELL COMPLETION DATA:


- (1) diameter (inches) 4
- (2) total depth (feet) 336
- (3) static water level (feet) 96 below top of ground.
- (4) casing pvc, 336  
 (material) (depth)  
4x2 if telescope see back.  
 (size)
- (5) screen 10, 326  
 (length) (depth to top)  
12, pvc  
 (size) (material)
- (6) pump 1, 20  
 (HP) (yield gpm)  
Elect  
 (type power)
- (7) electric log no  
 (yes or no)

(organization running log)

(8) how well bottom plugged Sand  
Shale

DRILLERS REMARKS:

description of formations encountered	from	to
<u>Red Shale</u>	<u>0</u>	<u>20</u>
<u>Red Sand</u>	<u>20</u>	<u>60</u>
<u>Blue Shale</u>	<u>60</u>	<u>90</u>
<u>Grey Sand</u>	<u>90</u>	<u>150</u>
<u>Blue Shale</u>	<u>150</u>	<u>250</u>
<u>Grey Sand</u>	<u>250</u>	<u>336</u>

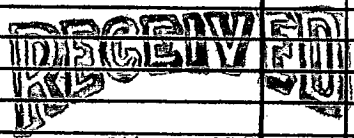


MAY 26 1992

Dept. of Environmental Quality  
 Bureau of Land & Water Resources

If well telescopes please sketch and show depths.

GROUND LEVEL

16764-2" | 1204-4"

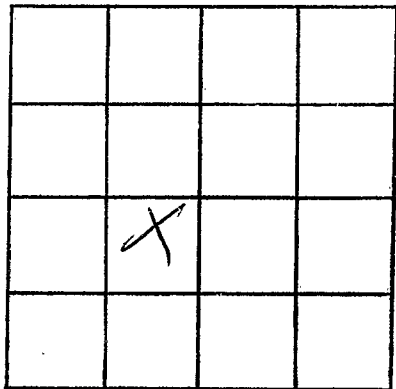

SECTION \_\_\_\_\_

Please indicate well location X.

ADDITIONAL INFORMATION

If more than one screen, show locations of each on sketch.