

PEARL RIVER

V2184

MISSISSIPPI
BOARD OF WATER COMMISSIONERS
416 North State Street
Jackson, Mississippi 39201

WATER WELL DRILLERS LOG

7/3/80

log 3

19 PANCEY WATER WELL DRILLING

Pearl River

date well completed

firm name

county well located

LANDOWNER:

John Enzoo

description of formations encountered

from

to

Rt. 1

Picayune, MS
(mailing address)

Top. 0 20
SD - 1/2 sand - clay 10 150

mix
clay 150 500

SD (Good) 500 5208

WELL LOCATION:

sec 31 T 5 N R 16 E
S W
3 miles N of Sycamore
(distance) (direction) (nearest town)

WELL PURPOSE: Home
(home, irrigation, municipal, industrial)

WELL COMPLETION DATA:

- (1) diameter (inches) 2
- (2) total depth (feet) 528
- (3) static water level (feet) 32 below top of ground
- (4) casing PVC 518
(material) (depth)
2 (size) if telescope see back.
- (5) screen 10 518
(length) (depth to top)
2 PVC
(size) (material)
- (6) pump 1 10
(HP) (yield gpm)
220V AC
(type power)
- (7) electric log (yes or no)

(organization running log)

(8) how well bottom plugged Sealed

DRILLERS REMARKS: Good well.


DEPT. OF NATURAL RESOURCES
BUREAU OF LAND & WATER RESOURCES

AUG 11 1980

RECEIVED

If well telescopes please sketch and show depths.

GROUND LEVEL

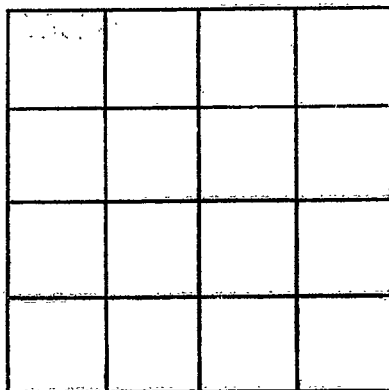

SECTION _____

Please indicate well location X.

ADDITIONAL INFORMATION

If more than one screen,
show locations of each on sketch.