

Pearl Riv
2129
~~V 2000~~
6-26-81

MISSISSIPPI
 BOARD OF WATER COMMISSIONERS
 416 North State Street
 Jackson, Mississippi 39201

WATER WELL DRILLERS LOG

6-26 1981 Penton Well Serv Pearl River
 date well completed firm name county well located

LANDOWNER: Judy Wyatt
56 Doubleton Dr.
Carriere Ms.
 (mailing address)

| description of formations encountered | from | to |
|---------------------------------------|------------|------------|
| <u>Surface Clay</u> | <u>0</u> | <u>360</u> |
| <u>Sand</u> | <u>360</u> | <u>408</u> |

WELL LOCATION:
 sec. 8 T 5 N R 16 E
 S W
2 miles E. of Carriere
 (distance) (direction) (nearest town)

WELL PURPOSE: Home
 (home, irrigation, municipal, industrial)


- WELL COMPLETION DATA:
- (1) diameter (inches) 2
 - (2) total depth (feet) 408
 - (3) static water level (feet) 42 below above
 top of ground.
 - (4) casing PVC, 398,
 (material) (depth)
2
 (size) If telescope see back.
 - (5) screen 10', 398
 (length) (depth to top)
2, PVC
 (size) (material)
 - (6) pump 1, 12
 (HP) (yield gpm)
Elec.
 (type power)
 - (7) electric log No
 (yes or no)
 - (organization running log)
 - (8) how well bottom plugged BW Valve

DRILLERS REMARKS:



If well telescopes please sketch and show depths.

GROUND LEVEL

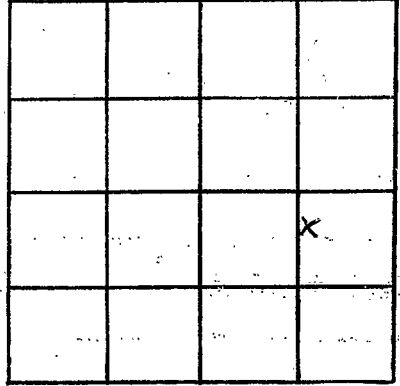

SECTION 8

Please indicate well location X.

ADDITIONAL INFORMATION

If more than one screen,
show locations of each on sketch.