

W1

7-2-63

WATER WELL DRILLERS LOG

Date: 7-2, 1963, Driller: Sutter Well Works County Pearl River
 (Name)

(1) Owner of Land: Monie & Sons
 (Name)
Memphis Tennessee
 (Address)

(2) Location: NW 1/4, SE 1/4, Sec. 39 T6S R17W
1 miles 1N of Nicholson
 (distance) (direction) (Nearest Town)

(3) Topography: flat
 (Hilly) (Flat) (Level)

(4) Purpose of Well: Industrial
 (Domestic Irrigation
 Municipal, Industrial, Other)

Description & Color of Materials Sand, Clay, Red Clay, Shell, etc.	Thick- ness Feet	Depth Feet
Clay	14	14
Sand	14	28
Clay	8	36
Sand - gravel	38	74

Information upon completion of well:

(1) Diameter 6 inches.

(2) Total Depth 74 feet.

(3) Water Level 18 feet below top of ground.


(4) Cased to all, Size 6"

(5) Screen: Size 6", Length 30'

(6) Were any formations sealed against pollution?
yes, no.

If YES depth of formation _____
 Why _____

Drillers Remarks: _____

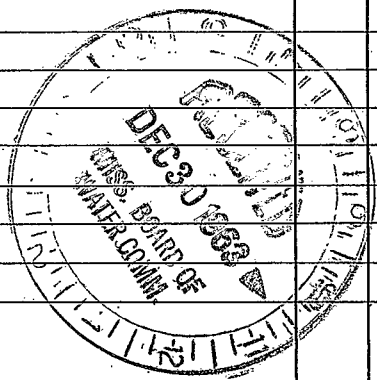

(Use Back Side)

Well No.

④