

P.R.
W
7-17-75

MISSISSIPPI
BOARD OF WATER COMMISSIONERS
416 North State Street
Jackson, Mississippi 39201

WATER WELL DRILLERS LOG

7/17 1975 Bud Penton & Son Pearl River
date well completed firm name county well located

LANDOWNER: Pine Grove
Church, Piquette
Miss.
(mailing address)


WELL LOCATION: 17
sec 28 T 6 N R 6 E
5 miles West of Piquette
(distance) (direction) (nearest town)

WELL PURPOSE: home
(home, irrigation, municipal, industrial)

WELL COMPLETION DATA:


- (1) diameter (inches) 2"
- (2) total depth (feet) 1531
- (3) static water level (feet) 284 ^{below}/_{above} top of ground.
- (4) casing 260, 1565
(material) (depth)
no (size) if telescope see back.
- (5) screen 25, 15-3-5
(length) (depth to top)
12, S.S. Steel
(size) (material)
- (6) pump no
(HP) (yield gpm)
(type power)
- (7) electric log no
(yes or no)
(organization running log)
- (8) how well bottom plugged Sand
Shark.

| description of formations encountered | from | to |
|---------------------------------------|------|------|
| white shale | 0 | 21 |
| white sandstone | 21 | 91 |
| Blue shale | 91 | 275 |
| Blue sand | 275 | 386 |
| Blue shale | 386 | 672 |
| Blue sand | 672 | 750 |
| Blue shale | 750 | 910 |
| Gray sand | 910 | 940 |
| Blue shale | 940 | 1520 |
| Gray sand | 1520 | 1531 |

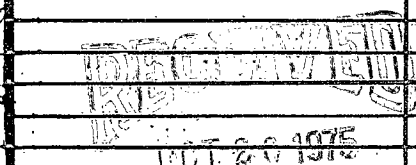

If well telescopes please
sketch and show depths.

GROUND LEVEL

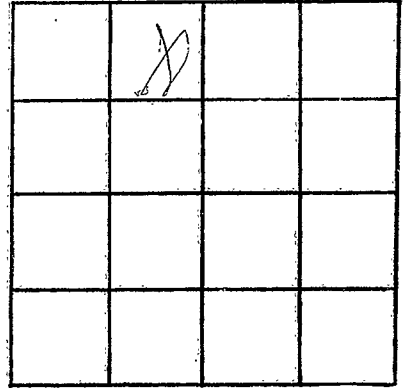

SECTION _____

Please indicate well location X.

ADDITIONAL INFORMATION

If more than one screen,
show locations of each on sketch.