

13 65 17W

CODED

Pearl River
W 14
10-68

MISSISSIPPI
BOARD OF WATER COMMISSIONERS
416 North State Street
Jackson, Mississippi 39201

CODED

WATER WELL DRILLERS LOG

10-11 1968 Sutter Well Works Pearl River
date well completed firm name county well located

LANDOWNER: E B Walker

Picayune

Miss
(mailing address)

WELL LOCATION:

sec 13 T 6 N R 19 E
⑤ (S) (W)
_____ miles E of Picayune
(distance) (direction) (nearest town)

WELL PURPOSE: Home
(home, irrigation, municipal, industrial)

WELL COMPLETION DATA:

- (1) diameter (inches) 2 x 1 1/2
- (2) total depth (feet) 551
- (3) static water level (feet) _____ below above top of ground.
- (4) casing galv. 541'
(material) (depth)
2 x 1 1/2" if telescope see back.
(size)
- (5) screen 10' 541'
(length) (depth to top)
2" stainless steel
(size) (material)
- (6) pump 1/2 10
(HP) (yield gpm)
elec
(type power)
- (7) electric log no
(yes or no)

(organization running log)
- (8) how well bottom plugged B.P. Walker


description of formations encountered

from to

| | | |
|-------------|------------|------------|
| <u>Clay</u> | <u>0</u> | <u>10</u> |
| <u>sand</u> | <u>10</u> | <u>50</u> |
| <u>Clay</u> | <u>50</u> | <u>105</u> |
| <u>sand</u> | <u>105</u> | <u>147</u> |
| <u>Clay</u> | <u>147</u> | <u>195</u> |
| <u>sand</u> | <u>195</u> | <u>210</u> |
| <u>Clay</u> | <u>210</u> | <u>528</u> |
| <u>sand</u> | <u>528</u> | <u>551</u> |

NOTE

Had slight flow

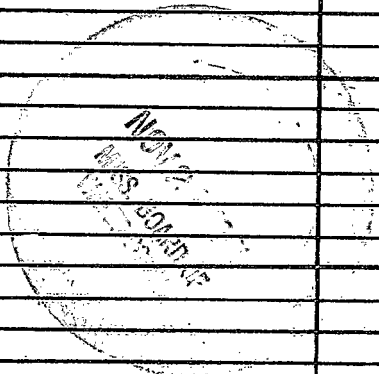

DRILLERS REMARKS:

If well telescopes please sketch and show depths.

GROUND LEVEL

42' of 2"

499' of 1 1/2" galv.

2 x 10' S.S. Strum.

| | | | |
|--|--|--|--|
| | | | |
| | | | |
| | | | |
| | | | |

SECTION _____

Please indicate well location X.

ADDITIONAL INFORMATION

If more than one screen, show locations of each on sketch.