

Pearl River
W17
5-15-69

MISSISSIPPI
 BOARD OF WATER COMMISSIONERS
 416 North State Street
 Jackson, Mississippi 39201

WATER WELL DRILLERS LOG

5-15 1969 Porton Well Serv Pearl River
 date well completed firm name county well located


LANDOWNER:	description of formations encountered	from	to
<u>Leon McQueen</u>	<u>Surface Clay</u>	<u>0</u>	<u>38</u>
<u>Neal Rd-</u>	<u>Sand & Gravel</u>	<u>38</u>	<u>105</u>
<u>Picayune Miss</u>	<u>Blue Clay</u>	<u>105</u>	<u>170</u>
(mailing address)	<u>Fine Sand</u>	<u>170</u>	<u>185</u>
WELL LOCATION:	<u>Blue Clay</u>	<u>185</u>	<u>202</u>
sec. <u>39T</u> <u>6</u> S R. <u>17</u> W	<u>Corey Sand</u>	<u>202</u>	<u>236</u>
<u>0</u> miles <u>West</u> of <u>Nicholson</u>			
(distance) (direction) (nearest town)			
WELL PURPOSE: <u>Industrial</u>			
(home, irrigation, municipal, industrial)			
WELL COMPLETION DATA: <u>4 1/2 Drill</u>			
(1) diameter (inches) <u>2"</u>			
(2) total depth (feet) <u>236</u>			
(3) static water level (feet) <u>20</u> below top of ground.			
(4) casing <u>Galv</u> <u>231</u>			
(material) (depth)			
<u>2"</u> if telescope see back.			
(size)			
(5) screen <u>5'</u> <u>231</u>			
(length) (depth to top)			
<u>2"</u> <u>S. Steel</u>			
(size) (material)			
(6) pump <u>1/2</u> <u>15</u>			
(HP) (yield gpm)			
<u>Elec</u>			
(type power)			
(7) electric log <u>NO</u>			
(yes or no)			
(organization running log)			
(8) how well bottom plugged <u>Bw. Valve</u>			
DRILLERS REMARKS:			

MAY 20 1969

MISS. BD. OF
 WATER COMMISSIONERS

If well telescopes please sketch and show depths.

GROUND LEVEL

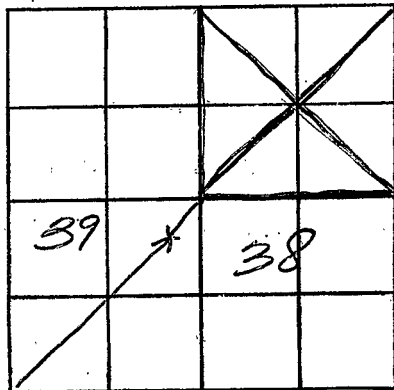

SECTION 39

Please indicate well location X.

ADDITIONAL INFORMATION

If more than one screen,
show locations of each on sketch.