

Pearl River
W 18
8-30-69

MISSISSIPPI
BOARD OF WATER COMMISSIONERS
416 North State Street
Jackson, Mississippi 39201

WATER WELL DRILLERS LOG

8-30 1969 Pentagon well serv Pearl River
date well completed firm name county well located

LANDOWNER: Allen Michot
2409 Lawrence Lane
Murray La.
(mailing address)

description of formations encountered	from	to
	Surface Clay	0
Sand & Gravel	38	115
Blue Clay	115	182
Brown Clay	182	200
Grey sand	200	236

WELL LOCATION:
sec. 3 T. 7 S. R. 17 W.
0 miles South of Nicholson
(distance) (direction) (nearest town)

WELL PURPOSE: Home
(home, irrigation, municipal, industrial)

- WELL COMPLETION DATA: 4 1/2
- (1) diameter (inches) 2"
 - (2) total depth (feet) 236
 - (3) static water level (feet) 21 below top of ground.
 - (4) casing Galv. 231 (material), (depth)
2" (size) if telescope see back.
 - (5) screen 5' 231 (length), (depth to top)
2" 3. steel (size), (material)
 - (6) pump 1/2 10 (HP), (yield gpm)
Elec (type power)
 - (7) electric log NO (yes or no)
(organization running log)
 - (8) how well bottom plugged B.W. Valve


DRILLERS REMARKS:

SEP 1 1969

ED. JF
COMMA

If well telescopes please sketch and show depths.

GROUND LEVEL.

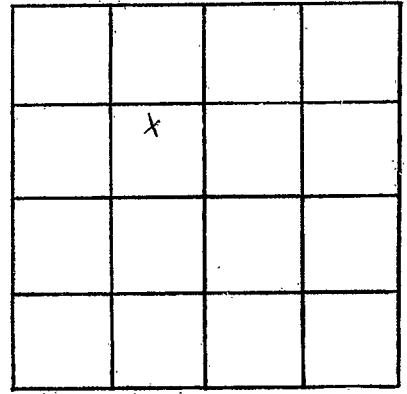

SECTION 3

Please indicate well location X.

ADDITIONAL INFORMATION

A series of horizontal lines for writing additional information.

If more than one screen, show locations of each on sketch.