

Pearl R.
W 20
12-14-64

WATER WELL DRILLERS LOG

W 20

Date: 12-14, 1964, Driller: Little Well Works County Pearl River
(Name)

(1) Owner of Land: Crosby Forest Prod.
(Name)
Picayune
(Address)
(2) Location: 1/4, 1/4, Sec. 16 T6 R17 W
miles 1N, or Picayune
(distance) (direction) (Nearest Town)
(3) Topography: flat
(Hilly) (Flat) (Level)
(4) Purpose of Well: Industrial
(Domestic Irrigation
Municipal, Industrial, Other)

Description & Color of Materials Sand, Clay, Red Clay, Shell, etc.	Thick- ness Feet	Depth Feet
Sand & gravel	75	75
Clay	26	101
Sand	22	123
Clay - sand streaks	52	175
Sand	82	257
Clay	19	276
Sand	146	422
Clay	133	555
Sand	85	640
Clay	180	820
Sand	50	870
Clay	95	965
Sand	145	1110


Information upon completion of well:

(1) Diameter 6 inches.
(2) Total Depth 1110 feet.
(3) Water Level 30 feet above below top of ground.
(4) Cased to all, Size 6"
(5) Screen: Size 6", Length 40'
(6) Were any formations sealed against pollution?
no yes, no.

303127
089438

CODED

If YES depth of formation _____
Why _____
Drillers Remarks: _____

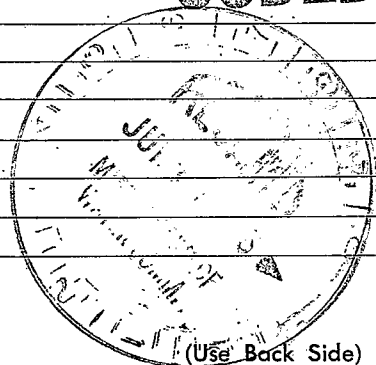

Well No.

