

W 21  
11-4-63

(21) ✓

WATER WELL DRILLERS LOG

Date: 11-4, 1963, Driller: Sutter Well Works County Pearl River  
(Name)

(1) Owner of Land: Crosby Forest Products  
(Name)  
Picayune, Miss.  
(Address)  
(2) Location: 1/4, 1/4, Sec. 29 N T6 R17,  
miles 1N of Picayune,  
(distance) (direction) (Nearest Town)  
(3) Topography: flat  
(Hilly) (Flat) (Level)  
(4) Purpose of Well: Industrial  
(Domestic Irrigation  
Municipal, Industrial, Other)


Description & Color of Materials Sand, Clay, Red Clay, Shell, etc.	Thick-ness Feet	Depth Feet
Clay	42	42
sand & gravel	28	70
Clay	73	143
sand	95	238
Clay	24	262
sand	29	291
Clay sand st.	70	361
sand	73	434
Clay	30	464
sand	45	509
Clay	48	557
sand	99	656
Clay	75	731
sand	19	750
Clay	72	822
sand	43	865
Clay	141	1006
sand	103	1109

Information upon completion of well:

(1) Diameter 4 inches.  
(2) Total Depth 1109 feet.  
(3) Water Level 35 feet above below top of ground.  
(4) Cased to all, Size 4"  
(5) Screen: Size 4", Length 20'  
(6) Were any formations sealed against pollution?  
no.

30.31 27  
089 438

**CODED**

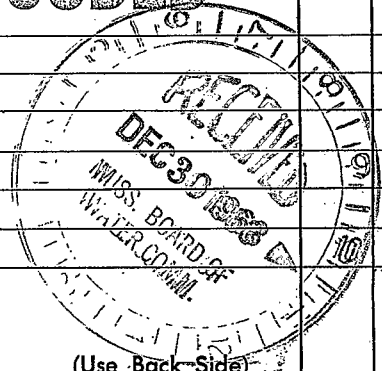

(Use Back Side)

Well No.

