

Pearl River
W 2'2
12-66
Elec Log

MISSISSIPPI
BOARD OF WATER COMMISSIONERS
416 North State Street
Jackson, Mississippi 39201

WATER WELL DRILLERS LOG

DEC 19 1966 Sutter Well Works PEARL RIVER
date well completed firm name county well located

LANDOWNER: CROSBY CHEMICAL
Pineyview, Miss.
(mailing address)


description of formations encountered	from	to
Clay	0	18
Sand & gravel	18	64
Clay	64	185
Sand	185	218
Clay	218	286
Sand & gravel	286	397

WELL LOCATION:
sec 29 T 6 N R 17 E
1 miles SW of Pineyview
(distance) (direction) (nearest town)

WELL PURPOSE: INDUSTRIAL
(home, irrigation, municipal, industrial)

- WELL COMPLETION DATA:
- (1) diameter (inches) 12 x 9 7/8
 - (2) total depth (feet) 397
 - (3) static water level (feet) 52 below above top of ground.
 - (4) casing STEEL, 322'
(material) (depth)
12" if telescope see back.
(size)
 - (5) screen 75', 322'
(length) (depth to top)
9 7/8", STAINLESS STEEL
(size) (material)
 - (6) pump 150 1000
(HP) (yield gpm)
ELEC
(type power)
 - (7) electric log YES
(yes or no)
SCHLUMBERGER
(organization running log)
 - (8) how well bottom plugged BP VALVE

DRILLERS REMARKS:

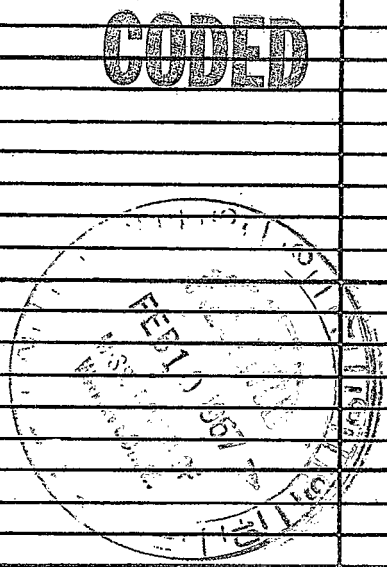

8


If well telescopes please sketch and show depths.

W. 2

GROUND LEVEL

322' of 12" BLACK

75' of 9 1/8" Screen

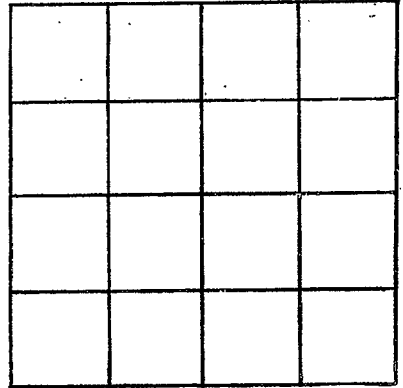

SECTION _____

Please indicate well location X.

ADDITIONAL INFORMATION

If more than one screen, show locations of each on sketch.