

Pearl River

W 25

2-2-70

MISSISSIPPI
 BOARD OF WATER COMMISSIONERS
 416 North State Street
 Jackson, Mississippi 39201

CODED

WATER WELL DRILLERS LOG

2-2

date well completed

1970 E & J Water Well Serv Pearl River

firm name

county well located

LANDOWNER:

George W. Warden

Rt. 2 Piquette, Miss.
(mailing address)

WELL LOCATION:

sec. 3 T. 6 N R. 18 E
 5 miles N-W. of Piquette
 (distance) (direction) (nearest town)

description of formations encountered

	from	to
Red Surface Clay	0	14
Coarse white sd	14	58
Blue clay	58	140
Fine Gray sd	140	150
Blue clay	150	232
Fine Gray sd	232	260
med. Gray sd	260	278

WELL PURPOSE:

Home (home, irrigation, municipal, industrial)

WELL COMPLETION DATA:

- (1) diameter (inches) 4.5
- (2) total depth (feet) 278
- (3) static water level (feet) 32 below top of ground.
- (4) casing 2" Galv. (material) 273 (depth)
 (size) If telescope see back.
- (5) screen 5' (length) 273 (depth to top)
2" (size) S.S. (material)
- (6) pump 1 (HP) 500 Hr. (yield gpm)
Elect (type power)
- (7) electric log NO (yes or no)

CODED

(organization running log)

(8) how well bottom plugged shoe


FEB 26 1970

MISS. BD. OF WATER COM.

DRILLERS REMARKS:

If well telescopes please sketch and show depths.

GROUND LEVEL

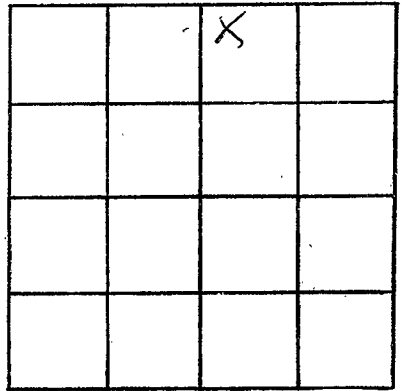

SECTION 3

Please indicate well location X.

ADDITIONAL INFORMATION

If more than one screen,
show locations of each on sketch.