

Pearl

WATER WELL DRILLERS LOG

W-31

10-8-60

Date 10-8, 1960, Driller: Trick & Grace County Pearl River

CODED

(Name)

(1) Owner of Land Charles Carter

(Name)

Pecayune, Miss

(Address)

(2) Location: 1/4, 1/4, Sec. 37 T6 R7

3 miles S West, of Pecayune
(distance) (direction) (Nearest Town)

(3) Topography: X (Hilly) X (Flat) (Level)

(4) Purpose of Well: Domestic
(Domestic Irrigation, Municipal, Industrial, Other)

Description & Color of Materials
Sand, Clay, Red Clay, Shell, etc.

Thick-
ness
Feet

Depth
Feet

<u>Surface clay</u>	<u>0</u>	<u>25</u>
<u>Sand + gravel str.</u>	<u>25</u>	<u>75</u>
<u>Blue clay</u>	<u>75</u>	<u>380</u>
<u>gray sand</u>	<u>380</u>	<u>515</u>
<u>Blue clay</u>	<u>515</u>	<u>900</u>
<u>gas & gray sand</u>	<u>900</u>	<u>954</u>

Information upon completion of well:

(1) Diameter 2 inches.

(2) Total Depth 954 feet.

(3) Water Level Flow feet below top of ground.

(4) Cased to _____, Size _____

(5) Screen: Size 2", Length 20'

(6) Were any formations sealed against pollution?


_____ yes, X no

If YES depth of formation _____

Why _____

Drillers Remarks: 60 gal Per
2.5 lbs Pressure.

CODED

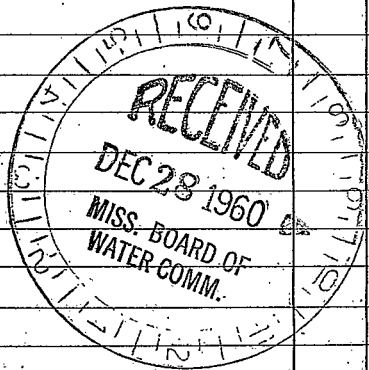

#24 Well No

(Use Back Side)

