

Pearl R.
W-32
5-5-61

WATER WELL DRILLERS LOG

W-309

Date: May 5, 1961, Driller: A.S. Fogg County Pearl River
(Name)


(1) Owner of Land: Elwood Andrews
(Name)
Picayune Miss
(Address)
37
(2) Location: 1/4, 1/4, Sec. 27 T.6 R.12
2 miles South, of Picayune
(distance) (direction) (Nearest/Town)
(3) Topography: Level
(Hilly) (Flat) (Level)
(4) Purpose of Well: Domestic
(Domestic Irrigation
Municipal, Industrial, Other)

Description & Color of Soil	Thickness Feet	Depth Feet
Clay		22
Sand		66
Clay	3	57
Stratified		22
Gravel		39
Clay	1	76
Sand		32
Clay	1	76
Sand	2	20

CODED

Information upon completion of well:

(1) Diameter 2 inches.
(2) Total Depth 1110 feet.
(3) Water Level Flowing feet below top of ground.
(4) Cased to bottom, Size 2"
(5) Screen: Size 2", Length 30 ft
(6) Were any formations sealed against pollution?
yes, no no.

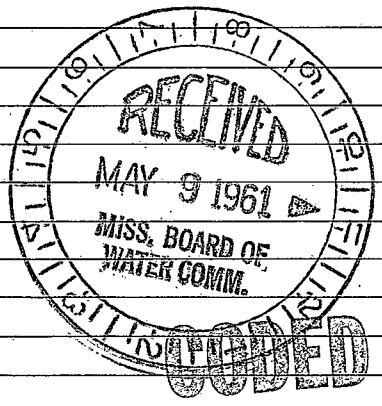

1110 ft

If YES depth of formation _____
Why _____
Drillers Remarks: _____

(Use Back Side)

Well No. 1

