

W-36

1-17-64

WATER WELL DRILLERS LOG

Date: 1-17, 1964 Driller: Walter Pearson County Pearl River
 4948
 4296

CODED

(1) Owner of Land: Eli Alsobrooks
 (Name)

Rt. 1 Picayune Miss
 (Address)

(2) Location: 1/4, 1/4, Sec. 26 T6 R17

2 1/2 miles West, of Nichols
 (distance) (direction) (Nearest Town)

(3) Topography: level
 (Hilly) (Flat) (Level)

(4) Purpose of Well: Domestic
 (Domestic Irrigation
 Municipal, Industrial, Other)

Description & Color of Materials Sand, Clay, Red Clay, Shell, etc.	Thick- ness Feet	Depth Feet
0 to 18' clay	18	18
18 to 87 sand & gravel	69	87
87 to 335 - clay	248	335
335 to 360 sand	25	360
360 to 385 clay	25	385
385 to 570 sandy clay	125	570
570 to 715 blue clay	205	715
715 to 738 sand	23	738
738 to 930 blue clay	192	930
930 to 982 sand	52	982

Information upon completion of well:

(1) Diameter 2 inches.

(2) Total Depth 982 feet.

(3) Water Level Flow feet below top of ground.

(4) Cased to _____, Size _____

(5) Screen: Size .10, Length 30'

(6) Were any formations sealed against pollution?

_____ yes, _____ no.

If YES depth of formation _____


Why _____

Drillers Remarks: 19 lbs water

Pressure

6 in. Rock @ 738'

CODED

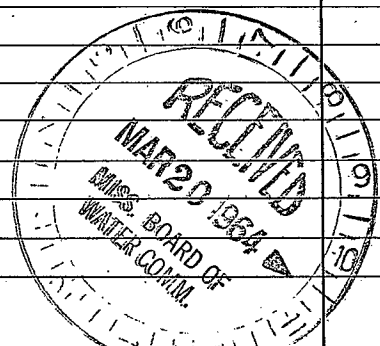

(Use Back Side)

Well No.

