

W-38
10-19-64

WATER WELL DRILLERS LOG

CODED

Date: 10-19, 1964, Driller: Walter Penton County Pearl River
(Name)

- (1) Owner of Land: Joe Mars
(Name)
Picayune Miss
(Address)
- (2) Location: 1/4, 1/4, Sec. 21 T6 R17,
1/2 miles S-W of Picayune
(distance) (direction) (Nearest Town)
- (3) Topography: Flat
(Hilly) (Flat) (Level)
- (4) Purpose of Well: Domestic
(Domestic Irrigation
Municipal, Industrial, Other)

Description & Color of Materials Sand, Clay, Red Clay, Shell, etc.	Thick- ness Feet	Depth Feet
Surface Clay	36	0-36
Sand & Gravel	46	82
Blue Clay	174	256
Sand	39	295
Blue Clay	43	338
Sand	28	366
Blue Clay	36	402
Sand	114	516
Blue Clay	12	528
Sand	28	556
Blue clay	148	704
sand	14	718
Blue clay	226	944
Sand		1011

Information upon completion of well:


- (1) Diameter 2 inches.
- (2) Total Depth 1011 feet.
- (3) Water Level Flow feet below top of ground.
- (4) Cased to _____, Size _____
- (5) Screen: Size 010-012, Length 20'
- (6) Were any formations sealed against pollution?
_____ yes, _____ no.

If YES depth of formation _____

Why _____

Drillers Remarks: 17 # Pressure

CODED

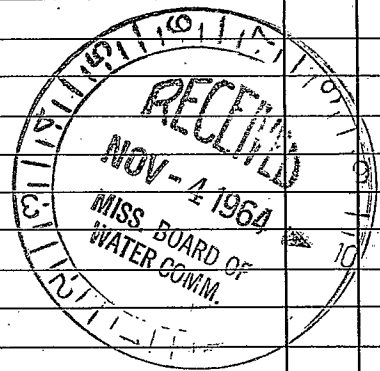

(Use Back Side)

Well No.

Faint, illegible text, possibly bleed-through from the reverse side of the page.