

P. R.
W60
9-11-74

MISSISSIPPI
BOARD OF WATER COMMISSIONERS
416 North State Street
Jackson, Mississippi 39201 CODED

WATER WELL DRILLERS LOG

9-11 date well completed
1974 Lumphreys Well Dr. firm name
Pearl River county well located

LANDOWNER:
Mr. Harold Daniels
Pearl River, Miss
(mailing address)

WELL LOCATION:
sec. 8 T. 6 N. R. 17 E.
2 miles East of Pearl River
(distance) (direction) (nearest town)


WELL PURPOSE: Home
(home, irrigation, municipal, industrial)

WELL COMPLETION DATA:

(1) diameter (inches) 2"
(2) total depth (feet) 1156'
(3) static water level (feet) 6" below top of ground.
(4) casing Gal. 1136' (material) (depth)
2" if telescope see back. (size)
(5) screen 20' 1136' (length) (depth to top)
2" Stainless Steel (size) (material)
(6) pump No (HP) (yield gpm)
No (type power)
(7) electric log No (yes or no)
(organization running log)
(8) how well bottom plugged


description of formations encountered	from	to
Clay	0	20
S. Sl	20	70
Clay	70	147
Sand	147	225
Clay	225	275
Sand	275	430
Clay	430	600
Sand	600	670
Clay	670	820
Sand	820	885
CODED Clay	885	980
Sand	980	1025
Clay	1025	1060
Sand	1060	1156

DRILLERS REMARKS:

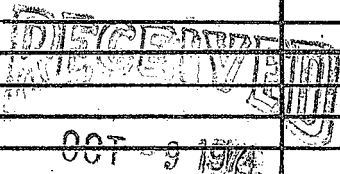

If well telescopes please sketch and show depths.

GROUND LEVEL

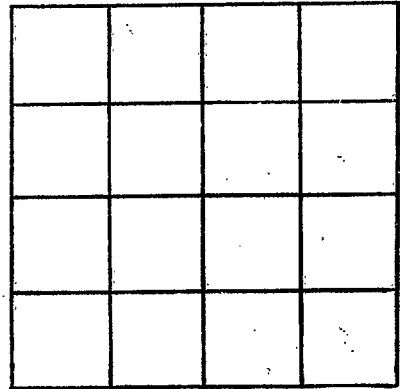

SECTION _____

Please indicate well location X.

ADDITIONAL INFORMATION

If more than one screen, show locations of each on sketch.