

P.R.
W62
5/1/74

MISSISSIPPI
BOARD OF WATER COMMISSIONERS
416 North State Street
Jackson, Mississippi 39201

CODED

WATER WELL DRILLERS LOG

S-1 1974 *Paul Penton & Son* *Paul Penn*
date well completed firm name county well located

LANDOWNER: *Mr. Karl Picayune Miss*

description of formations encountered	from	to
<i>Red Shale</i>	<i>0</i>	<i>9</i>
<i>Sand & Rock</i>	<i>9</i>	<i>90</i>
<i>Blue Shale</i>	<i>90</i>	<i>300</i>
<i>Gray Sand</i>	<i>300</i>	<i>335</i>

(mailing address)

WELL LOCATION:

sec. *10* T. *6* N. R. *18* E.
2 miles *W* of *Picayune*
(distance) (direction) (nearest town)

WELL PURPOSE: *Home*
(home, irrigation, municipal, industrial)

WELL COMPLETION DATA:

- (1) diameter (inches) *2 in*
- (2) total depth (feet) *335*
- (3) static water level (feet) *8* below top-of-ground above
- (4) casing *PVC* *325*
(material) (depth)
(size) if telescope see back.
- (5) screen *2x10* *325*
(length) (depth-to top)
12 *PVC*
(size) (material)
- (6) pump *1/2* *450*
(HP) (yield gpm)
electric
(type power)
- (7) electric log *no*
(yes or no)

(organization running log)

(8) how well bottom plugged
Sand Shale

DRILLERS REMARKS:


CODED

RECEIVED
MAY 10 1974

MISS. BD. OF WATER CONTROL

If well telescopes please sketch and show depths.

GROUND LEVEL

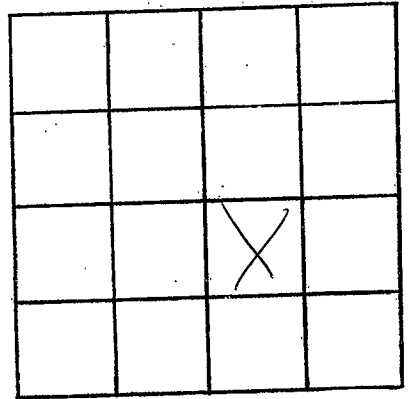

SECTION _____

Please indicate well location X.

ADDITIONAL INFORMATION

If more than one screen, show locations of each on sketch.