

W-65
10-30-64

WATER WELL DRILLERS LOG

CODED

Date: 10-30, 1964, Driller: Walter Ponton County: River
767-140 (Name)

(1) Owner of Land: Wiley Frierson
(Name)
Picayune Miss
(Address)

(2) Location: 1/4, 1/4, Sec. 3 T 7 R 17
0 miles South of Nicholson
(distance) (direction) (Nearest Town)

(3) Topography: Flat
(Hilly) (Flat) (Level)

(4) Purpose of Well: Domestic
(Domestic Irrigation
Municipal, Industrial, Other)

Description & Color of Materials Sand, Clay, Red Clay, Shell, etc.	Thick- ness Feet	Depth Feet
Surface Clay	16	0-16
Sand	26	42
Sand + Gravel	73	115
Blue Clay Sandy	193	308
Sand	44	352
Blue Clay	84	436
Sand	112	548
Blue Clay	204	752
Sand	12	764
Blue Clay	75	839
Sand	18	857
Blue Clay	57	908
Sand		969

Information upon completion of well:

(1) Diameter 2 inches.

(2) Total Depth 969 feet.

(3) Water Level Flow feet below top of ground.

(4) Cased to _____, Size _____

(5) Screen: Size 010-012, Length 20'


(6) Were any formations sealed against pollution?
_____ yes, _____ no.

If YES depth of formation _____

Why _____

Drillers Remarks: 19# Pressure

CODED

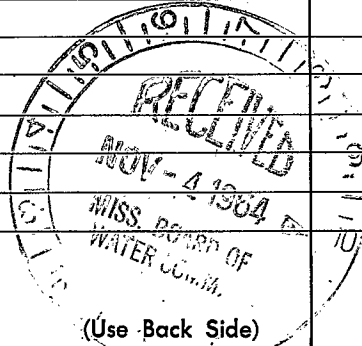

Well No.

1870

1871

1872

1873