

W-66  
11-27-64

**WATER WELL DRILLERS LOG**

Date: 11-27, 1964, Driller: Walter Patton County: Pearl River  
(Name)

**CODED**

(1) Owner of Land: Eli Alsobrooks  
(Name)  
Pearl River LA-  
(Address)

(2) Location: 1/4, 1/4, Sec. 26 T6 R17,  
3/4 miles West of Nicholson  
(distance) (direction) (Nearest Town)  
MISS.

(3) Topography: Flat  
(Hilly) (Flat) (Level)

(4) Purpose of Well: Domestic  
(Domestic Irrigation  
Municipal, Industrial, Other)

Description & Color of Materials Sand, Clay, Red Clay, Shell, etc.	Thick- ness Feet	Depth Feet
Surface Clay	18	0-18
Sand	8	26
Yellow clay	14	40
Sand + Gravel	76	116
Blue clay	74	190
Grey Sand	70	260
Blue clay	135	395
Grey Sand	131	526
Blue clay	97	623
Grey Sand	17	650
Blue clay	230	880
Grey Sand		965

Information upon completion of well:

(1) Diameter 2 inches.

(2) Total Depth 965 feet.

(3) Water Level Flow feet below top of ground.

(4) Cased to \_\_\_\_\_, Size \_\_\_\_\_


(5) Screen: Size 010-012, Length 20'

(6) Were any formations sealed against pollution?  
\_\_\_\_\_ yes, \_\_\_\_\_ no.

If YES depth of formation \_\_\_\_\_

Why \_\_\_\_\_

Drillers Remarks: 18 lbs. Pressure

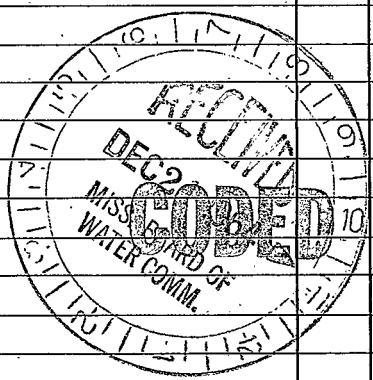

(Use Back Side)

Well No.

