

Pearl R.
W 70
11-29-74

MISSISSIPPI
BOARD OF WATER COMMISSIONERS
416 North State Street
Jackson, Mississippi 39201

CODED

WATER WELL DRILLERS LOG

11-29 1974 Bud Linton & Son Pearl River
date well completed firm name county well located

LANDOWNER: J.R. Tate
Pocahontas, Miss.

description of formations encountered	from	to
Red shale	0	27
White sand & silt	27	110
Blue shale	110	260
Blue sand fine	260	310
Blue shale	310	412
Grey sand	412	435

(mailing address)

WELL LOCATION:
sec. 4 T. 6 N. R. 17 E.
1 1/2 miles (distance) E(?) (direction) Pocahontas (nearest town)

WELL PURPOSE: Home
(home, irrigation, municipal, industrial)

- WELL COMPLETION DATA:
- (1) diameter (inches) 2 in
 - (2) total depth (feet) 435
 - (3) static water level (feet) 42 below top-of-ground
 - (4) casing Galv. 415 (material) (depth)

CODED

- (5) screen 2x10 415 (length) (depth to top)
2x10, Stanton Steels (size) (material)
- (6) pump 1 650 (HP) (yield gpm)
electric (type power)
- (7) electric log NO (yes or no)

(organization running log)

(8) how well bottom plugged
Bud Linton


DRILLERS REMARKS:

RECEIVED

APR 9 1975

If well telescopes please sketch and show depths.

GROUND LEVEL

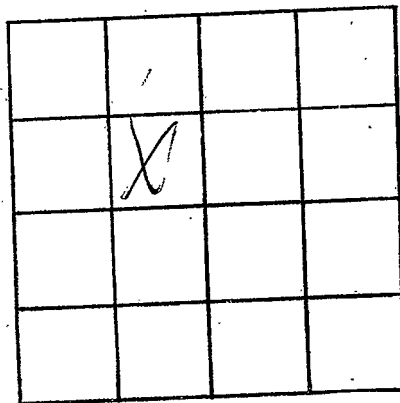

SECTION _____

Please indicate well location X.

ADDITIONAL INFORMATION

If more than one screen, show locations of each on sketch.