

Pearl R.
W 75
8-6-60

WATER-WELL DRILLERS LOG

~~W-303~~

Date: 8-6, 1960, Drilled by Quick & Luce County P.R.
(Name) From to

- (1) Owner of Land: Wesley Patch
(Name)
Permyne Miss.
(Address)
- (2) Location: SW 1/4, SE 1/4, Sec. 8 T.6 R.17
W
3 miles west, of Permyne
(distance) (direction) (Nearest Town)
- (3) Topography: ✓
(Hilly) (Flat) (Level)
- (4) Purpose of Well: Domestic
(Domestic Irrigation
Municipal, Industrial, Other)

Description & Color of Materials Sand, Clay, Red Clay, Shell, etc.	Thick- ness Feet	Depth Feet
<u>Surface clay</u>	<u>0</u>	<u>35</u>
<u>Loose & gravel</u>	<u>35</u>	<u>90</u>
<u>Clay</u>	<u>90</u>	<u>155</u>
<u>Sand</u>	<u>155</u>	<u>175</u>
<u>Clay</u>	<u>175</u>	<u>270</u>
<u>Sand</u>	<u>270</u>	<u>440</u>
<u>Clay</u>	<u>440</u>	<u>615</u>
<u>Sand</u>	<u>615</u>	<u>685</u>
<u>Clay</u>	<u>685</u>	<u>750</u>
<u>Sand</u>	<u>750</u>	<u>815</u>
<u>Blue Clay</u>	<u>815</u>	<u>855</u>
<u>Good Sand</u>	<u>855</u>	<u>900</u>
<u>Blue Clay</u>	<u>900</u>	<u>1055</u>
<u>Good Sand</u>	<u>1055</u>	<u>1193</u>


Information upon completion of well:

- (1) Diameter: 2 inches.
- (2) Total Depth: 1193 feet.
- (3) Water Level: Flow +58' feet below top of ground.
- (4) Cased to _____, Size _____
- (5) Screen: Size 2", Length 20'
- (6) Were any formations sealed against pollution?
_____ yes, No no.

If YES depth of formation _____

Why _____

Drillers Remarks: 60 gal Per
25 lbs Pressure

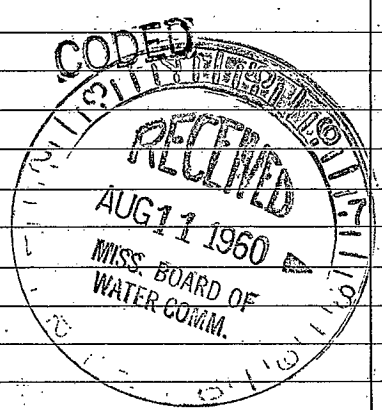

Well No. 70

(Use Back Side)

