

Pearl River
W 76
5-27-69

MISSISSIPPI
 BOARD OF WATER COMMISSIONERS
 416 North State Street
 Jackson, Mississippi 39201

CODED

WATER WELL DRILLERS LOG

5-27 1969 Penton Well Serv Pearl River
 date well completed firm name county well located


LANDOWNER: <u>A.M. Abraham</u>	description of formations encountered		from	to
<u>607 Rosa St</u>	<u>Surface Clay</u>		<u>0</u>	<u>16</u>
<u>Picayune Miss.</u>	<u>SAND</u>		<u>16</u>	<u>26</u>
(mailing address)	<u>White Clay</u>		<u>26</u>	<u>38</u>
	<u>Sand</u>		<u>38</u>	<u>70</u>
WELL LOCATION:	<u>Blue Clay</u>		<u>70</u>	<u>290</u>
sec. <u>13</u> T. <u>6</u> S. R. <u>17</u> W.	<u>Grey Sand</u>		<u>290</u>	<u>360</u>
<u>0</u> miles <u>East</u> of <u>Picayune</u>	<u>Blue Clay</u>		<u>360</u>	<u>372</u>
(distance) (direction) (nearest town)	<u>Grey sand</u>		<u>372</u>	<u>398</u>
WELL PURPOSE: <u>Home</u>	<u>Blue Clay</u>		<u>398</u>	<u>435</u>
(home, irrigation, municipal, industrial)	<u>Grey Sand</u>		<u>435</u>	<u>455</u>
WELL COMPLETION DATA:	<u>Blue Clay</u>		<u>455</u>	<u>568</u>
(1) diameter (inches) <u>2"</u>	<u>Silt</u>		<u>568</u>	<u>600</u>
(2) total depth (feet) <u>1069</u>	<u>Blue Clay</u>		<u>600</u>	<u>954</u>
(3) static water level (feet) <u>Flow</u> ^{meter} above top of ground.	<u>Fine Sand</u>		<u>945</u>	<u>1030</u>
(4) casing <u>Black</u> <u>1049</u>	<u>Grey Sand</u>		<u>1030</u>	<u>1069</u>
(material) (depth)				
<u>2"</u> If telescope see back.				
(size)				
(5) screen <u>20'</u> <u>1049</u>				
(length) (depth to top)				
<u>.015</u> <u>2"</u> <u>St. Steel</u>				
(size) (material)				
(6) pump <u>65</u>				
(HP) (yield gpm)				
(type power)				
(7) electric log <u>NO</u>				
(yes or no)				
(organization running log)				
(8) how well bottom plugged <u>B.W. Valve</u>				
DRILLERS REMARKS: <u>21 lbs Pressure</u>				

JUL 11 1969

MISS. Bd. of
 WATER COMMISSIONERS

If well telescopes please sketch and show depths.

GROUND LEVEL

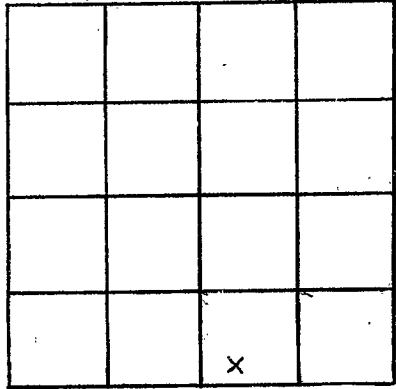

SECTION 13

Please indicate well location X.

ADDITIONAL INFORMATION

If more than one screen,
show locations of each on sketch.