

PEARL RIVER
W 80
10-24-69

MISSISSIPPI
BOARD OF WATER COMMISSIONERS
416 North State Street
Jackson, Mississippi 39201

CODED

WATER WELL DRILLERS LOG

10-24 1969 Penton Well Serv Pearl River
date well completed firm name county well located

LANDOWNER: Don Raby
2210 Hwy-11 North
Picayune Miss
(mailing address)

description of formations encountered	from	to
	Surface Clay	0
Sand & Gravel	38	90
Blue Clay	90	266
Mud	266	285
Blue Clay	285	340
Grey Sand	340	387

WELL LOCATION:
sec. 20 T. 6 S. R. 17 E. W. W
1/2 miles (distance) W (direction) of Picayune (nearest town)

WELL PURPOSE: Home
(home, irrigation, municipal, industrial)

- WELL COMPLETION DATA:
- (1) diameter (inches) 2"
 - (2) total depth (feet) 387
 - (3) static water level (feet) 32 below top of ground.
 - (4) casing Galv (material), 377 (depth).
2" (size) if telescope see back.
 - (5) screen 5 (length), 377 (depth to top).
2" (size), S. Steel (material)
 - (6) pump 1/2 (HP), 14 (yield gpm).
Elec (type power)
 - (7) electric log NO (yes or no)
 - (organization running log)
 - (8) how well bottom plugged B.W. Valve


NOV 13 1969

DRILLERS REMARKS:

MISS. BD. OF
WELL DRILLERS COMM.

If well telescopes please sketch and show depths.

GROUND LEVEL

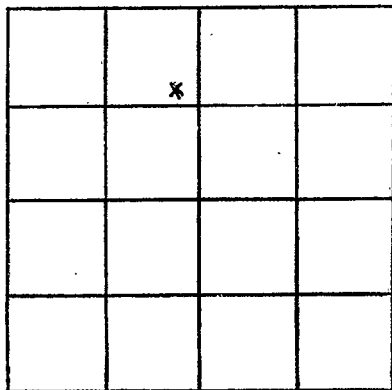

SECTION 20

Please indicate well location X.

ADDITIONAL INFORMATION

If more than one screen,
show locations of each on sketch.