

PEARL RIVER  
 W 81  
 11-12-69

MISSISSIPPI  
 BOARD OF WATER COMMISSIONERS  
 416 North State Street  
 Jackson, Mississippi 39201

CODED

WATER WELL DRILLERS LOG

11-12 date well completed  
 1969 Patton Well Serv Pearl River firm name  
 county well located

LANDOWNER: Claude Furr  
 Rt. 4 Box 504  
 Picayune MISS  
 (mailing address)

WELL LOCATION:  
 sec. 28 T 6 N R 17 E  
 3 miles South of Picayune  
 (distance) (direction) (nearest town)

WELL PURPOSE: Home  
 (home, irrigation, municipal, industrial)

WELL COMPLETION DATA: 4' in

(1) diameter (inches) 2"  
 (2) total depth (feet) 963  
 (3) static water level (feet) Flow <sup>below</sup> above top of ground.  
 (4) casing Black <sup>steel</sup> 943  
 (material) (depth)  
 2" if telescope see back.  
 (size)  
 (5) screen 20' 943  
 (length) (depth to top)  
 015- 2" S. steel  
 (size) (material)  
 (6) pump 48  
 (HP) (yield gpm)  
 (type power)  
 (7) electric log NO  
 (yes or no)  
 (organization running log)  
 (8) how well bottom plugged BU Valve

description of formations encountered	from	to
Surface Clay	0	32
Sand & Gravel	32	90
Blue clay	90	153
Fine sand	153	165
Blue clay	165	374
Corey sand	374	500
Blue clay	500	630
Corey sand	630	650
Blue clay	650	890
Corey sand	890	963


DRILLERS REMARKS: 16 lbs  
 Pressure at ground  
 level

DEC - 8 1969

MISS. BD. OF  
 WATER COMM.

If well telescopes please sketch and show depths.

GROUND LEVEL

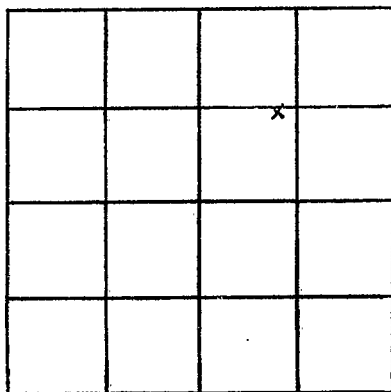

SECTION 28

Please indicate well location X.

ADDITIONAL INFORMATION

If more than one screen,  
show locations of each on sketch.