

Pearl River
W 83
3-26-70

MISSISSIPPI
BOARD OF WATER COMMISSIONERS
416 North State Street
Jackson, Mississippi 39201

WATER WELL DRILLERS LOG

3-26 1971 date well completed
L W Smith Pearl River firm name
county well located

LANDOWNER:
D A Shaw
Sumberton, Miss.
(mailing address)

description of formations encountered	from to	
	feet	feet
Sand	0	20
Clay	20	23
Sand & Gravel	23	65

WELL LOCATION:
sec. 11 T. 1 R. 14 16A
7 miles SE of Sumberton
(distance) (direction) (nearest town)

WELL PURPOSE:
(home, irrigation, municipal, industrial)


- WELL COMPLETION DATA:
- (1) diameter (inches) 2"
 - (2) total depth (feet) 65
 - (3) static water level (feet) 4 below above top of ground.
 - (4) casing (material) Plastic 60 (depth)
 - (size) if telescope see back.
 - (5) screen 5' 60' (length) (depth to top)
 - (size) (material)
 - (6) pump No Pump (HP) (yield gpm)
 - (type power)
 - (7) electric log (yes or no)
 - (organization running log)
 - (8) how well bottom plugged

DRILLERS REMARKS:
Free Strada of water

MAY 1 1971
MISS. DIV. OF WATER SUPPLY

If well telescopes please sketch and show depths.

GROUND LEVEL

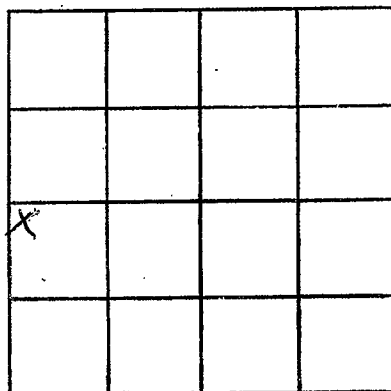

SECTION _____

Please indicate well location X.

ADDITIONAL INFORMATION

If more than one screen, show locations of each on sketch.