

Pearl River
W 84
5-22-70

MISSISSIPPI
 BOARD OF WATER COMMISSIONERS
 416 North State Street
 Jackson, Mississippi 39201


WATER WELL DRILLERS LOG

5-22 19 70 NEIL LUMPKIN WELL DRILLING SERVICE Pearl River
 P. O. BOX 117
 date well completed BARLIERE, MISS. county well located

LANDOWNER: <u>Huey Stockstill</u>	description of formations encountered	from	to
<u>Pecayune</u> <u>Route</u> (mailing address)			
WELL LOCATION: sec. <u>37</u> T. <u>7</u> R. <u>17</u> <u>074</u> <u>3</u> miles <u>W</u> of <u>Nicholson</u> (distance) (direction) (nearest town)	<u>Surface Clay</u>	<u>0</u>	<u>5</u>
WELL PURPOSE: <u>Camp</u> (home, irrigation, municipal, industrial)	<u>Sand + gravel</u>	<u>5</u>	<u>85</u>
WELL COMPLETION DATA: (1) diameter (inches) <u>2"</u>	<u>Blue clay</u>	<u>85</u>	<u>300</u>
(2) total depth (feet) <u>965</u>	<u>Grey sand</u>	<u>300</u>	<u>400</u>
(3) static water level (feet) <u>28.0</u> below top of ground. <u>42 gal. on top</u> pressure	<u>Blue clay, hard</u>	<u>400</u>	<u>530</u>
(4) casing (material) <u>HP</u> (depth) <u>164</u>	<u>Good grey sand</u>	<u>530</u>	<u>615</u>
<u>2"</u> if telescope see back. (size)	<u>Blue clay & shale</u>	<u>615</u>	<u>900</u>
(5) screen <u>10</u> (length) (depth to top)	<u>Beautiful sand</u>	<u>900</u>	<u>965</u>
<u>2"</u> (size) <u>St. Steel</u> (material)			
(6) pump (HP) (yield gpm)			
(type power)			
(7) electric log <u>no</u> (yes or no)			
(organization running log)			
(8) how well bottom plugged <u>Johnson</u> <u>BP Valve</u>			
DRILLERS REMARKS: <u>28 lbs. pressure</u>			

If well telescopes please sketch and show depths.

GROUND LEVEL

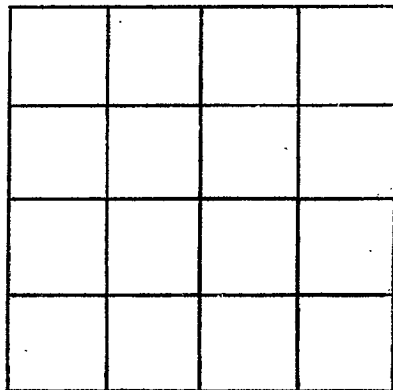

SECTION _____

Please indicate well location X.

ADDITIONAL INFORMATION

If more than one screen, show locations of each on sketch.