

Pearl River  
W 85  
5-13-70

MISSISSIPPI  
 BOARD OF WATER COMMISSIONERS  
 416 North State Street  
 Jackson, Mississippi 39201

WATER WELL DRILLERS LOG

NEIL LUMPKIN WELL DRILLING  
 P. O. BOX 117  
 GARDNER, MISS.

Pearl River

5-13 1970  
 date well completed

GARDNER, MISS.

county well located

LANDOWNER: Virgil Boone

Picayune  
Route

(mailing address)

description of formations encountered

from

to

Surface Clay	0	12 1/2
Sand + gravel	12 1/2	55
blue clay	55	200
Good grey sand	200	300
blue clay	300	500
grey sand	500	650
blue clay	650	760
fine to perfect sand	760	885

WELL LOCATION:

sec. 2 T. 6 S. R. 18 E. 074

5 1/2 miles NE of Picayune  
 (distance) (direction) (nearest town)

WELL PURPOSE: home  
 (home, irrigation, municipal, industrial)

WELL COMPLETION DATA:

- (1) diameter (inches) 2"
- (2) total depth (feet) 885
- (3) static water level (feet) 22 below top of ground. lbs above

(4) casing plb  
 (material) (depth)

2"  
 (size) if telescope see back.

(5) screen 10  
 (length) (depth to top)

2" St. Steel  
 (size) (material)

(6) pump \_\_\_\_\_  
 (HP) (yield gpm)

(type power)

(7) electric log no  
 (yes or no)

(organization running log)

(8) how well bottom plugged Johnson

JUN 1 1970


DRILLERS REMARKS:

22 lbs pressure  
42 ft. galv. on top

MISS. Bd. of  
 Water Comm.

If well telescopes please sketch and show depths.

GROUND LEVEL

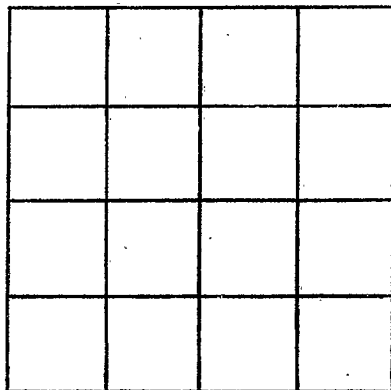

SECTION \_\_\_\_\_

Please indicate well location X.

ADDITIONAL INFORMATION

If more than one screen, show locations of each on sketch.