

Pearl River
W 87
7-20-70

MISSISSIPPI
BOARD OF WATER COMMISSIONERS
416 North State Street
Jackson, Mississippi 39201

CODED

WATER WELL DRILLERS LOG

7-20 1970 Neil Simpson Pearl River
date well completed firm name county well located

LANDOWNER Donald
Bushby
Picayune, Miss.
(mailing address)

WELL LOCATION:
sec. 3 T. 6 R. 17
3 miles NW of Picayune
(distance) (direction) (nearest town)

WELL PURPOSE: home
(home, irrigation, municipal, industrial)

WELL COMPLETION DATA:

(1) diameter (inches) 2"

(2) total depth (feet) 1043'

(3) static water level (feet) 46' below above top of ground.

(4) casing plk
(material) (depth)
2" if telescope see back.
(size)

(5) screen 20'
(length) (depth to top)
2 St. Steel
(size) (material)

(6) pump _____ (HP) _____ (yield gpm)
(type power)

(7) electric log no
(yes or no)

(organization running log)

description of formations encountered	from	to
Surface Clay	0	20
Good sand	20	50
Blue Clay	50	160
band, no good	160	190
Clay	190	210
Good sand	210	231
Clay	231	484
Good Sand	484	525
Clay	525	567
band	567	609
Clay	609	777
band	777	820
Clay	820	950
Good Sand	950	1043

CODED

SEP 22 1970


(8) how well bottom plugged Johnson
B.P. Valve

DRILLERS REMARKS:
18 lbs. pressure

MISS. RD. OF
WATER COM.

If well telescopes please sketch and show depths.

GROUND LEVEL

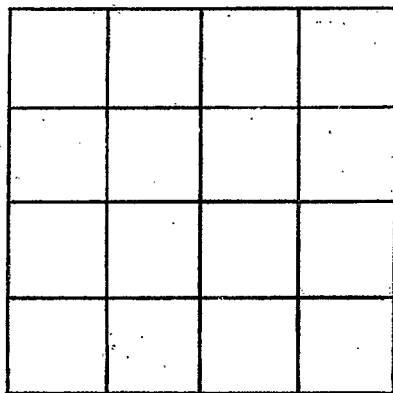

SECTION _____

Please indicate well location X.

ADDITIONAL INFORMATION

If more than one screen, show locations of each on sketch.