

Pearl River  
W 89  
5-16-70

MISSISSIPPI  
BOARD OF WATER COMMISSIONERS  
416 North State Street  
Jackson, Mississippi 39201

**CODED**

WATER WELL DRILLERS LOG

5-16 1970 Ponton Well Serv Pearl River  
date well completed firm name county well located

LANDOWNER: Hilbur Stewart  
Rt. 4 Box 74  
Picayune Miss  
(mailing address)

WELL LOCATION:  
sec. 8 T. 6 S. R. 17 E.  
0 miles West of Picayune  
(distance) (direction) (nearest town)

WELL PURPOSE: Home  
(home, irrigation, municipal, industrial)

WELL COMPLETION DATA:

- (1) diameter (inches) 2
- (2) total depth (feet) 1177
- (3) static water level (feet) Flow <sup>inflow</sup> above top of ground.
- (4) casing Black, 1157,  
(material) (depth)  
2 if telescope see back.  
(size)
- (5) screen 20', 1157  
(length) (depth to top)  
012 2", St. Steel  
(size) (material)
- (6) pump \_\_\_\_\_  
(HP) (yield gpm)  
  
(type power)
- (7) electric log NO  
(yes or no)  
  
(organization running log)
- (8) how well bottom plugged BW Value

description of formations encountered	from	to
Surface Clay	0	26
Sand + Gravel	26	85
Blue Clay	85	154
Fine sand	154	165
Blue Clay	165	390
Grey Sand	390	512
Blue Clay	512	590
Grey Sand	590	645
Blue Clay	645	812
Grey Sand	812	840
Blue Clay	840	1100
Grey Sand	1100	1177

**CODED**


JUN 16 1970

DRILLERS REMARKS: 22 lbs  
2' Ground level

MISS. ED. OF  
WATER COMM.

If well telescopes please sketch and show depths.

GROUND LEVEL

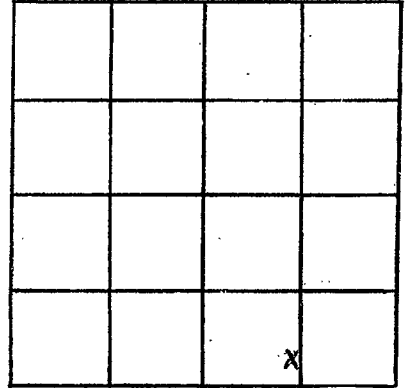

SECTION 8

Please indicate well location X.

ADDITIONAL INFORMATION

If more than one screen,  
show locations of each on sketch.