

Pearl River  
W 90  
5-22-70

MISSISSIPPI  
BOARD OF WATER COMMISSIONERS  
416 North State Street  
Jackson, Mississippi 39201

**CODED**

WATER WELL DRILLERS LOG

5-22  
date well completed

1970 Penton Well Serv  
firm name

Pearl River  
county well located

LANDOWNER: Carl Johnson

description of formations  
encountered

from to

113 Soniat Dr.

Surface Clay

0 28

Slidell La.

Sand & Gravel

28 80

(mailing address)

Blue Clay

80 197

WELL LOCATION:

Fine Sand

197 218

sec. 20 T. 6 R. 17  
1 miles West of Picayune  
(distance) (direction) (nearest town)

Blue Clay

218 337

Grey Sand

337 380

WELL PURPOSE: Home  
(home, irrigation, municipal, industrial)

WELL COMPLETION DATA:

(1) diameter (inches) 2  
(2) total depth (feet) 380  
(3) static water level (feet) 17 below above top of ground.

**CODED**

(4) casing Corlu, 375  
(material) (depth)

2 if telescope see back.  
(size)

(5) screen 5', 375  
(length) (depth to top)

012 2, S. Steel  
(size) (material)

(6) pump 1/2 8  
(HP) (yield gpm)

Elec.  
(type power)

(7) electric log NO  
(yes or no)

(organization running log)

(8) how well bottom plugged BW Valve


JUN 16 1970

DRILLERS REMARKS:

MISS. BD. OF  
WATER COMMA.

If well telescopes please sketch and show depths.

GROUND LEVEL

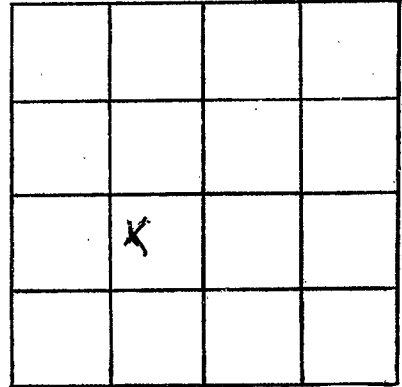

SECTION 20

Please indicate well location X.

ADDITIONAL INFORMATION

If more than one screen, show locations of each on sketch.