

Pearl River
W 91
6-8-70

MISSISSIPPI
 BOARD OF WATER COMMISSIONERS
 416 North State Street
 Jackson, Mississippi 39201

CODED

WATER WELL DRILLERS LOG

10-8 1970 Penton Well S of Pearl River
 date well completed firm name county well located

LANDOWNER: Lushie Albritten
Palatine Rd
Picayune Miss
 (mailing address)

WELL LOCATION:
 sec. 30 T 6 R 17
1 miles West of Picayune
 (distance) (direction) (nearest town)

WELL PURPOSE: HOME
 (home, irrigation, municipal, industrial)

WELL COMPLETION DATA:

- (1) diameter (inches) 2"
- (2) total depth (feet) 1176
- (3) static water level (feet) Flow ^{below} above top of ground.
- (4) casing Black, 1156
 (material) (depth)
2"
 (size) if telescope see back.
- (5) screen 30', 1156
 (length) (depth to top)
015 2", S. Steel
 (size) (material)
- (6) pump ✓
 (HP) (yield gpm)
✓
 (type power)
- (7) electric log NO
 (yes or no)
 (organization running log)
- (8) how well bottom plugged But Valve

description of formations encountered	from	to
Surface Clay	0	30
Sand - Gravel	30	83
Blue Clay	83	165
Fine Sand	165	182
Blue Clay	182	325
Grey Sand	325	485
Blue Clay	485	570
Grey Sand	570	595
Blue Clay	595	645
Grey Sand	645	695
Blue Clay	695	790
Grey Sand	790	817
Blue Clay	817	940
Mud	940	1010
Blue Clay	1010	1087
Grey Sand	1087	1176

CODED


JUL 10 1970

MISS. BD. OF
 WATER COMMISSIONERS

DRILLERS REMARKS: 22 lbs
at Ground level

If well telescopes please sketch and show depths.

GROUND LEVEL

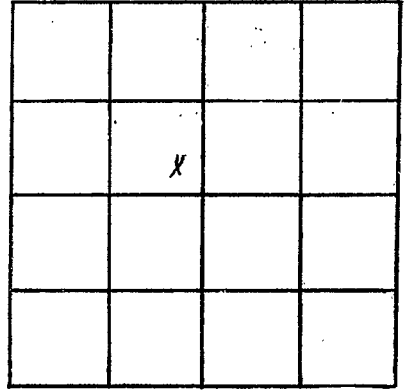

SECTION 20

Please indicate well location X.

ADDITIONAL INFORMATION

If more than one screen,
show locations of each on sketch.