

Pearl River
 W 93
 6-25-70

MISSISSIPPI
 BOARD OF WATER COMMISSIONERS
 416 North State Street
 Jackson, Mississippi 39201

CODED

WATER WELL DRILLERS LOG

6-25 1970 Penton Well Serv Pearl River
 date well completed firm name county well located

LANDOWNER: Earnest Furr
Section Line Rd.
Picayune Miss.
 (mailing address)

description of formations encountered	from	to
Surface clay	0	18
Sand	18	96
Blue Clay	96	170
Sand	170	185
Blue Clay	185	340
Grey sand	340	490
Blue Clay	490	572
Grey sand	572	590
Blue Clay	590	660
Grey sand	660	692
Blue Clay	692	765
Grey sand	765	820
Blue Clay	820	945
Silt	945	972
Blue Clay	972	1120
Grey sand	1120	1196

WELL LOCATION:
 sec. 20 T 6 R 17
 (distance) (direction) (nearest town)
1 miles West of Picayune

WELL PURPOSE: Home
 (home, irrigation, municipal, industrial)

- WELL COMPLETION DATA:
- (1) diameter (inches) 2
 - (2) total depth (feet) 1196
 - (3) static water level (feet) Flow ^{below} above top of ground.
 - (4) casing Black, 1176,
 (material) (depth)
2"
 (size) if telescope see back.
 - (5) screen 20, 1176
 (length) (depth to top)
015 2", S. Steel
 (size) (material)
 - (6) pump ✓
 (HP) (yield gpm)
 (type power)
 - (7) electric log NO
 (yes or no)
 (organization running log)
 - (8) how well bottom plugged BW Value

CODED


SEP 24 1970

DRILLERS REMARKS: 26 lbs
at ground level

MISS. BD. OF
 WATER COMM

If well telescopes please sketch and show depths.

GROUND LEVEL

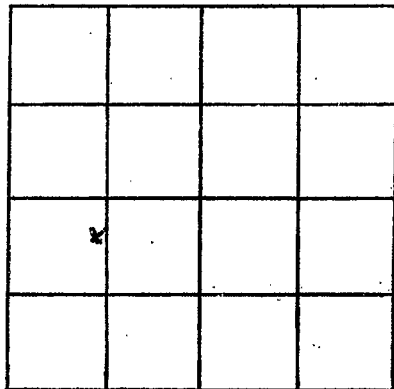

SECTION 20

Please indicate well location X.

ADDITIONAL INFORMATION

If more than one screen, show locations of each on sketch.