

PEARL RIVER

W 94

9-23-70

MISSISSIPPI BOARD OF WATER COMMISSIONERS  
416 North State Street  
Jackson, Mississippi 39201

**CODED**

WATER WELL DRILLERS LOG

9-23  
date well completed

1970 Ponton Well Serv  
firm name

Pearl River  
county well located

LANDOWNER: James T. Frierson

714 S. Hough Ave

Picayune Miss.  
(mailing address)

WELL LOCATION:

sec. 26 T 6 N R 17 E  
S W

1/2 miles south of Picayune  
(distance) (direction) (nearest town)

WELL PURPOSE: Home  
(home, irrigation, municipal, industrial)

WELL COMPLETION DATA:

- (1) diameter (inches) 4 1/2
- (2) total depth (feet) 1175
- (3) static water level (feet) flow below above top of ground.

(4) casing Black 1155  
(material) (depth)

2" If telescope see back.  
(size)

(5) screen 20' 1155  
(length) (depth to top)

015 2" S. Steel  
(size) (material)

(6) pump (HP) (yield gpm)

(type power)

(7) electric log No  
(yes or no)

(organization running log)

(8) how well bottom plugged Bill Valve

description of formations encountered

from to

Surface Clay	0	30
Sand	30	90
Blue Clay	90	322
Grey Sand	322	326
Blue Clay	326	360
Grey sand	360	450
Blue Clay	450	475
Grey sand	475	487
Blue Clay	487	535
Grey sand	535	538
Blue Clay	538	615
Grey sand	615	675
Blue Clay	675	815
Grey sand	815	895
Blue Clay	895	1130
Grey sand	1130	1175

**CODED**


OCT 8 1970

DRILLERS REMARKS:

MISS. BD. OF WATER COM.

If well telescopes please sketch and show depths.

GROUND LEVEL

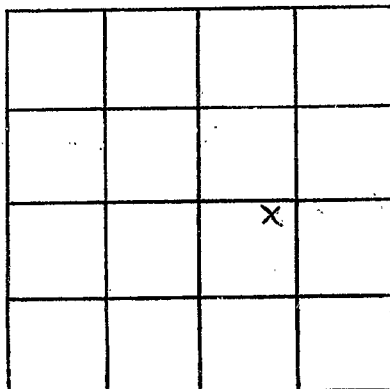

SECTION 26

Please indicate well location X.

ADDITIONAL INFORMATION

If more than one screen,  
show locations of each on sketch.