

PEARL RIVER
W 95
10-14-70

MISSISSIPPI
BOARD OF WATER COMMISSIONERS
 416 North State Street
 Jackson, Mississippi 39201

CODED

WATER WELL DRILLERS LOG

NEIL LUMPKIN WELL DRILLING SERVICE

P. O. BOX 117
 GARRIERS, MISS.
 firm name

Pearl River
 county well located

10-14 1970
 date well completed

LANDOWNER: Sam Stockstill
Picayune, Miss
Rt. 2, Box 333A
 (mailing address)

Description of formations encountered	from	to
Surface Clay	0	20
Sand	20	40
Gravel	40	60
Sand	60	80
Blue Clay	80	280
Good sand (pump)	280	340
Blue clay	340	400
Good sand	400	520
Blue clay	520	580
Good sand	580	700
Blue clay	700	750
good sand	750	816

WELL LOCATION:
 sec. R T. 6 S. R. 17 W.
2 miles West of Picayune
 (distance) (direction) (nearest town)

WELL PURPOSE: home
 (home, irrigation, municipal, industrial)

- WELL COMPLETION DATA:
- (1) diameter (inches) 2"
 - (2) total depth (feet) 816
 - (3) static water level (feet) 32 ^{below} above top of ground.
 - (4) casing plk (material), (depth)
 - 2" If telescope see back. (size)
 - (5) screen 20' (length), (depth to top)
 - 2" (size), (material)
 - (6) pump (HP), (yield gpm)
 - (type power)
 - (7) electric log no (yes or no)
 - (organization running log)
 - (8) how well bottom plugged Johnson back pressure valve

CODED


DEC 14 1970

MADE BY
 ENGINEER
 SURVEYOR

DRILLERS REMARKS:
16 lbs. pressure

If well telescopes please sketch and show depths.

GROUND LEVEL

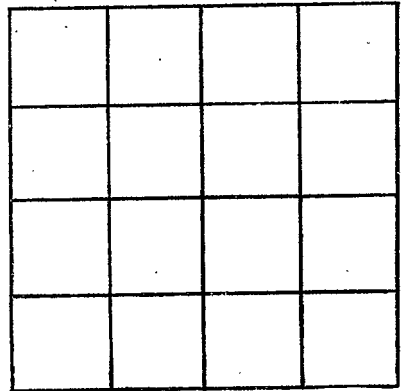

SECTION _____

Please indicate well location X.

ADDITIONAL INFORMATION

If more than one screen, show locations of each on sketch.