

PEARL RIVER
W 96
12-18-70

MISSISSIPPI
BOARD OF WATER COMMISSIONERS
416 North State Street
Jackson, Mississippi 39201

CODED

WATER WELL DRILLERS LOG

NEEL LUMPKIN WELL DRILLING SERVICE
P. O. BOX 117
Pearl River, MISS

Pearl River
county well located

12-18 1970
date well completed

Drill name

LANDOWNER: Robert Walls

description of fomations encountered from to

Picayune Route
(mailing address)

Surface clay 0 10
v sand 10 40

WELL LOCATION:
sec. 3 T. 6 S. R. 17 E
3 miles NW of Picayune
(distance) (direction) (nearest town)

Blue clay 40 280
Good sand 280 350

WELL PURPOSE: home
(home, irrigation, municipal, industrial)

Blue clay 350 500
Good sand 500 600

WELL COMPLETION DATA:

- (1) diameter (inches) 2"
- (2) total depth (feet) 987
- (3) static water level (feet) 46' below top of ground.
- (4) casing (material) (depth) 2" If telescope see back.
- (5) screen (length) (depth to top) 20
- (6) pump (HP) (yield gpm)
- (7) electric log (yes or no) No.
- (organization running log)
- (8) how well bottom plugged Johnson back pressure valve

Blue clay 600 750
Good sand 750 850
Blue clay 850 900
Good sand 900 987

20 lbs. pressure

CODED


FEB 2 1971

DRILLERS REMARKS:
2 pints (42) galv pipe on top of well

MISS. ED. OF
WATER COM.

If well telescopes please sketch and show depths.

GROUND LEVEL

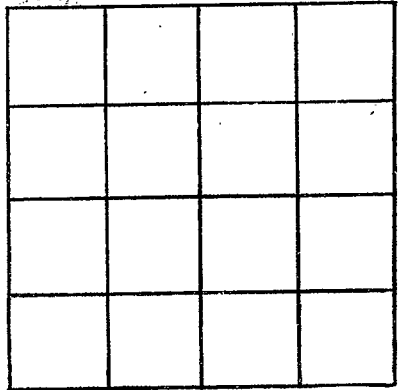

SECTION _____

Please indicate well location X.

ADDITIONAL INFORMATION

If more than one screen,
show locations of each on sketch.