

PEARL RIVER
W 98
2-5-71

MISSISSIPPI
 BOARD OF WATER COMMISSIONERS
 416 North State Street
 Jackson, Mississippi 39201

CODED

WATER WELL DRILLERS LOG

2-5 1971 Penton Well Serv Pearl River
 date well completed firm name county well located

LANDOWNER: Douglas Holcomb
P.O. Box 135
Nicholson Miss
 (mailing address)

WELL LOCATION:
 sec. 3 T. 7 S. R. 17 E. W.
0 miles South of Nicholson
 (distance) (direction) (nearest town)

WELL PURPOSE: Home
 (home, irrigation, municipal, industrial)

WELL COMPLETION DATA:

(1) diameter (inches) 2

(2) total depth (feet) 993

(3) static water level (feet) Flow ^{below} above top of ground.

(4) casing Galv, 973
 (material) (depth)

.015 2
 (size) If telescope see back.

(5) screen 20', 973
 (length) (depth to top)

2", S. Steel
 (size) (material)

(6) pump ✓
 (HP) (yield gpm)

✓
 (type power)

(7) electric log No
 (yes or no)

(organization running log)

(8) how well bottom plugged Bill Value

description of formations encountered	from	to
Surface Clay	0	21
Sand + Gravel	21	95
Blue Clay	95	220
Sand	220	290
Blue Clay	290	420
Sand	420	515
Blue Clay	515	595
Sand	595	625
Blue Clay	625	900
Sand	900	973

CODED


MAR 9 1971

DRILLERS REMARKS: 25 lbs
Pressure

MISSISSIPPI BOARD OF WATER COMMISSIONERS

If well telescopes please sketch and show depths.

GROUND LEVEL

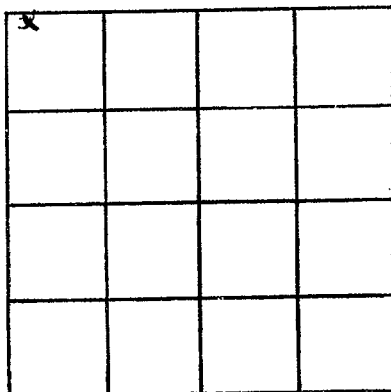

SECTION 3

Please indicate well location X.

ADDITIONAL INFORMATION

If more than one screen, show locations of each on sketch.