

Pearl R.
W-100
11-19-65

MISSISSIPPI BOARD OF WATER COMMISSIONERS

CODED

WATER WELL DRILLERS LOG

Date: NOV 19, 1965, Driller: Walter Penton County Pearl River
(Name)

(1) Owner of Land: James Stockstill
(Name)
Route Picayune Miss
(Address) 7 617

(2) Location: 1 miles West of Picayune
(distance) (direction) (Nearest Town)

(3) Topography: Flat
(Hilly) (Flat) (Level)

(4) Purpose of Well: Domestic
(Domestic Irrigation
Municipal, Industrial, Other)

Description & Color of Materials Sand, Clay, Red Clay, Shell, etc.	Thick- ness Feet	Depth Feet
Clay	16	0-16
Sand & Gravel	59	75
Blue clay	233	308
Sand	18	326
Blue clay	12	338
Sand	102	440
Blue clay	117	557
Sand	18	585
Blue clay	47	632
Sand	80	712
Blue clay	98	810
Sand	104	914

Information upon completion of well:

(1) Diameter 2 inches.

(2) Total Depth 914 feet.

(3) Water Level Flow feet below top of ground.

(4) Cased to _____, Size _____.


(5) Screen: Size .012, Length 20'.

(6) Were any formations sealed against pollution?
_____ yes, _____ no.

If YES depth of formation _____

Why _____

Drillers Remarks: 20 lbs Pressure
Ground level

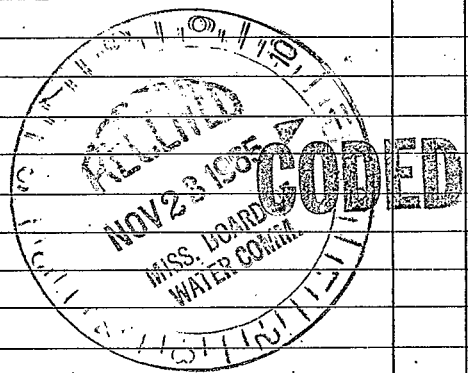

(Use Back Side)

Well No.

