

W-101
3-26-66

WATER WELL DRILLERS LOG

CODED

Date: 3-26, 1966, Driller: Walter Penton County Pearl River
1074-36 (Name)
995-26

(1) Owner of Land: Byrness Puyper
(Name)
Piczynce Miss
(Address)

(2) Location: 1/4, 1/4, Sec. 14 T6 R7,
0 miles So. W. of Piczynce
(distance) (direction) (Nearest Town)

(3) Topography: Flat
(Hilly) (Flat) (Level)

(4) Purpose of Well: Domestic
(Domestic Irrigation
Municipal, Industrial, Other)

Description & Color of Materials Sand, Clay, Red Clay, Shell, etc.	Thick- ness Feet	Depth Feet
<u>0-</u>		
<u>Yellow clay</u>	<u>28</u>	<u>0-28</u>
<u>Sand & Gravel</u>	<u>50</u>	<u>78</u>
<u>Blue clay</u>	<u>278</u>	<u>365</u>
<u>Grey sand</u>	<u>113</u>	<u>478</u>
<u>Blue clay</u>	<u>405</u>	<u>883</u>
<u>Fine Grey sand</u>	<u>60</u>	<u>943</u>
<u>Blue clay</u>		<u>1045</u>
<u>Grey sand</u>	<u>129</u>	<u>982</u>
		<u>1045</u>

Information upon completion of well:

(1) Diameter 2 inches.


(2) Total Depth 1045 feet.

(3) Water Level Flow feet below top of ground.

(4) Cased to _____, Size _____.

(5) Screen: Size 012, Length 20'.

(6) Were any formations sealed against pollution?
 _____ yes, _____ no.

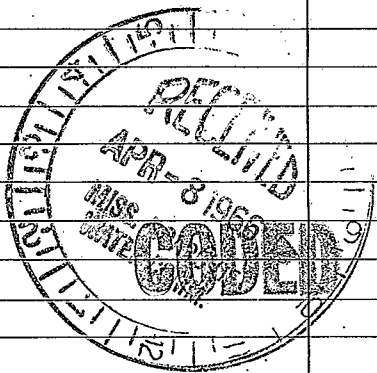

If YES depth of formation _____

Why _____

Drillers Remarks: 15 lbs Pressure
at Ground Level

(Use Back Side)

Well No.

