

PEARL RIVER
W103
9-27-71

MISSISSIPPI
BOARD OF WATER COMMISSIONERS
416 North State Street
Jackson, Mississippi 39201

WATER WELL DRILLERS LOG

CODED

9-27 1971 Penton well serv date well completed firm name county well located

LANDOWNER: Ruth Mitchell
1510 N. Blanks St
Picayune Miss
(mailing address)

description of formations encountered	from	to
Surface Clay	0	38
Sand + Gravel	38	95
Blue Sandy Clay	95	360
Sand	360	490
Blue Clay	490	720
Sand	720	825
Blue Clay	825	1100
Sand	1100	1196

WELL LOCATION:
sec. 16 T 6 S R 17 E W
1/4 miles West of Picayune
(distance) (direction) (nearest town)

WELL PURPOSE: Home
(home, irrigation, municipal, industrial)

- WELL COMPLETION DATA:
- (1) diameter (inches) 2
 - (2) total depth (feet) 1196
 - (3) static water level (feet) flow above top of ground.
 - (4) casing Galv. 1176 (material) (depth)
2 (size) if telescope see back.
 - (5) screen 20' 1176 (length) (depth to top)
2 (size) S. steel (material)
 - (6) pump (HP) (yield gpm)
(type power)
 - (7) electric log NO (yes or no)
(organization running log)
 - (8) how well bottom plugged B.W. Valve

CODED


NOV 9 1971

DRILLERS REMARKS: 20 lbs. Pressure at Ground level

MISS. BD. OF
WATER COMM.

If well telescopes please sketch and show depths.

GROUND LEVEL

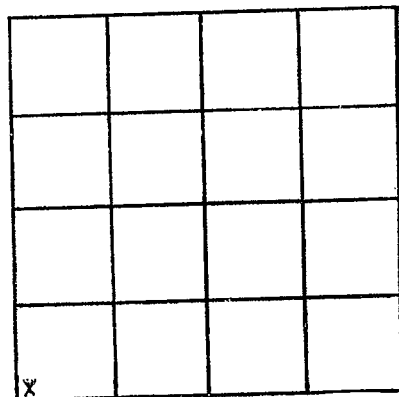

SECTION 16

Please indicate well location X.

ADDITIONAL INFORMATION

If more than one screen,
show locations of each on sketch.