

PEARL RIVER  
W104  
11-15-71

MISSISSIPPI  
BOARD OF WATER COMMISSIONERS  
416 North State Street  
Jackson, Mississippi 39201

1071  
**CODED**  
MISS.  
WA

WATER WELL DRILLERS LOG

11-15-71 date well completed      1971 Penton Well Serv firm name      Pearl River county well located

LANDOWNER: James Lee  
Pt. 1  
Picayune MISS-  
(mailing address)

description of formations encountered	from	to
Surface Clay	0	26
Sand + Gravel	26	105
Blue Clay	105	125
Mud	175	192
Blue Clay	192	365
Sand	365	430

WELL LOCATION:  
sec. 8 T. 6 S. R. 17 E. W.  
1/2 miles west of Picayune  
(distance) (direction) (nearest town)

WELL PURPOSE: Home  
(home, irrigation, municipal, industrial)

WELL COMPLETION DATA:

(1) diameter (inches) 2

(2) total depth (feet) 430

(3) static water level (feet) 29 below top of ground above

(4) casing Galv. 420 (material) (depth)  
2 (size) if telescope see back.

(5) screen 10 (length) 420 (depth to top)  
2 (size) S. Steel (material)

(6) pump 1/2 (HP) 9 (yield gpm)  
Elec (type power)

(7) electric log NO (yes or no)

(organization running log)


(8) how well bottom plugged B.W. Value

**CODED**

DRILLERS REMARKS:

If well telescopes please sketch and show depths.

GROUND LEVEL

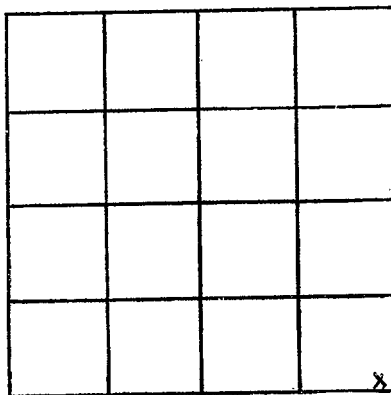

SECTION 8

Please indicate well location X.

ADDITIONAL INFORMATION

Lined area for providing additional information, consisting of multiple horizontal lines.

If more than one screen, show locations of each on sketch.