

PEARL RIVER
W106
12-21-71

MISSISSIPPI
BOARD OF WATER COMMISSIONERS
 416 North State Street
 Jackson, Mississippi 39201

MAR 9 1972

WATER WELL DRILLERS LOG


12-21 1971 Neil Lumpkin Well Pearl River
 date well completed firm name county well located
 Drilling Service

LANDOWNER: <u>R. R. Watts</u>	description of formations encountered	from	to
<u>Picayune, Miss.</u>			
(mailing address)	<u>Fine to better sand</u>	<u>10</u>	<u>85</u>
WELL LOCATION:			
sec. <u>R 6 E</u> R <u>17 E</u>			
<u>1</u> miles <u>N.</u> of <u>Picayune</u>			
(distance) (direction) (nearest town)			
WELL PURPOSE: <u>Home</u>			
(home, irrigation, municipal, industrial)			
WELL COMPLETION DATA:			
(1) diameter (inches) <u>2"</u>			
(2) total depth (feet) <u>85</u>			
(3) static water level (feet) <u>30</u> below above top of ground.			
(4) casing <u>plastic</u> (material) (depth)			
<u>2"</u> (size) if telescope see back.			
(5) screen <u>5'</u> (length) (depth to top)			
<u>24 plastic</u> (size) (material)			
(6) pump <u>1/2</u> (HP) <u>350 gph</u> (yield gpm)			
<u>electric</u> (type power)			
(7) electric log <u>No</u> (yes or no)			
(organization running log)			
(8) how well bottom plugged <u>Johnson</u>			
<u>BP Valve</u>			
DRILLERS REMARKS:			

CODED

If well telescopes please sketch and show depths.

GROUND LEVEL

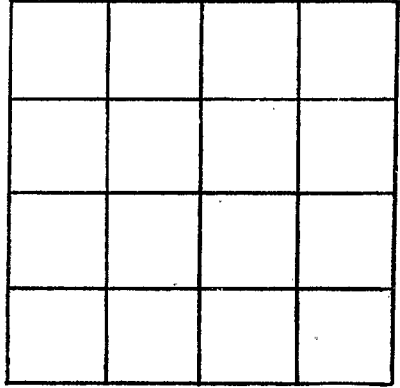

SECTION _____

Please indicate well location X.

ADDITIONAL INFORMATION

If more than one screen,
show locations of each on sketch.