

PEARL RIVER
W 110
6-14-72

MISSISSIPPI
 BOARD OF WATER COMMISSIONERS
 416 North State Street
 Jackson, Mississippi 39201

WATER WELL DRILLERS LOG

CODED

NEIL LUMPKIN WELL DRILLING SERVICE
 P. O. BOX 117
 CARROLLTON, MISS.

(Pearl River)

6-14 - 19 72
 date well completed

CARRIAGE, MISS.

county well located

LANDOWNER: James A. Prestidge
76 Patterson Dr.
Chalmette, La 70013
 (mailing address)

description of formations encountered

from to

Surface clay	0	20
Sand & gravel	20	60
Blue clay	60	160
Good sand	160	195

WELL LOCATION:

sec 30 T 6 R 17
8 miles W of Vicary
 (distance) (direction) (nearest town)

WELL PURPOSE: home (summer)
 (home, irrigation, municipal, industrial)

WELL COMPLETION DATA:

- (1) diameter (inches) 2"
- (2) total depth (feet) 195
- (3) static water level (feet) 7 below above top of ground.
- (4) casing galv. (material), (depth)
2" (size) if telescope see back.
- (5) screen 5' (length), (depth to top)
2" (size), St. Steel (material)
- (6) pump 1/2 (HP), 750 gph. (yield gph)
electric (type power)
- (7) electric log no (yes or no)

(organization running log)

(8) how well bottom plugged Johnson
BP valve

CODED


JUN 28 1972

DRILLERS REMARKS:

MISS. DEPT. OF
 WATER CONTROL

If well telescopes please sketch and show depths.

GROUND LEVEL

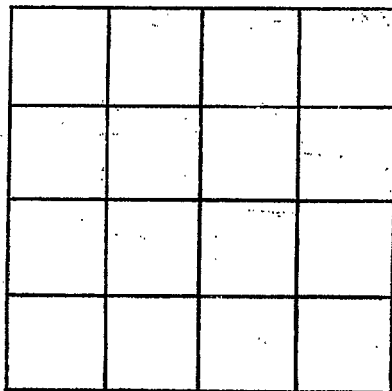

SECTION _____

Please indicate well location X.

ADDITIONAL INFORMATION

A series of horizontal lines providing space for additional information.

If more than one screen, show locations of each on sketch.