

**PEARL RIVER**  
**W 114**  
**7-25-72**

**COVERED**

MISSISSIPPI  
 BOARD OF WATER COMMISSIONERS  
 416 North State Street  
 Jackson, Mississippi 39201

**WATER WELL DRILLERS LOG**

7-25 1972 Peaton Well Serv Pearl River  
 date well completed firm name county well located

LANDOWNER: Leon M. Queen  
Neal Rd.  
Picayune Miss  
 (mailing address)

WELL LOCATION:  
 sec. 38 T. 6 M. R. 17 E.  
 S. W.  
1 miles North of Nicholson  
 (distance) (direction) (nearest town)

WELL PURPOSE: HOME  
 (home, irrigation, municipal, industrial)

WELL COMPLETION DATA: 4 1/2

- (1) diameter (inches) 2
- (2) total depth (feet) 960
- (3) static water level (feet) Flow above top of ground.
- (4) casing Galv. 940  
 (material) (depth)  
2 if telescope see back.  
 (size)
- (5) screen 20' 940  
 (length) (depth to top)  
012 2 steel  
 (size) (material)
- (6) pump ✓ ✓  
 (HP) (yield gpm)  
✓  
 (type power)
- (7) electric log NO  
 (yes or no)  
 (organization running log)
- (8) how well bottom plugged B.W. Valve


description of formations encountered	from	to
Surface Clay	0	30
Sand & Gravel	30	105
Blue Clay	105	395
Sand	395	510
Blue Clay	510	620
Sand	620	722
Blue Clay	722	795
Sand	795	820
Blue Clay	820	885
Sand	885	940

**APR 23 1972**  
 MISSISSIPPI  
 BOARD OF WATER COMMISSIONERS

DRILLERS REMARKS:  
18 lbs - at Ground level

If well telescopes please  
sketch and show depths.

GROUND LEVEL

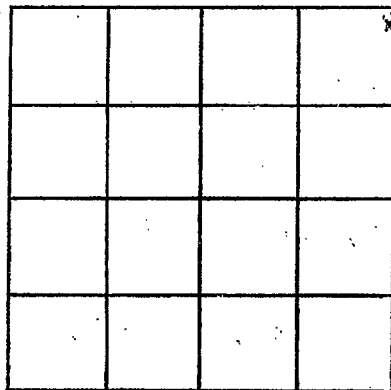

SECTION 38

Please indicate well location X.

ADDITIONAL INFORMATION

If more than one screen,  
show locations of each on sketch.