

PEARL RIVER
W 116
8-16-72

MISSISSIPPI
 BOARD OF WATER COMMISSIONERS
 416 North State Street
 Jackson, Mississippi 39201

CODÉD

WATER WELL DRILLERS LOG

8/16 1972 Birdington & Son Pearl River
 date well completed firm name county well located

LANDOWNER: Charles Kling
Archie La.
 (mailing address)

description of formations encountered	from	to
white shale	0	6
white sand	6	53
rocks		
blue shale	53	196
blue sandstone	196	321
hard rocks	321	321

WELL LOCATION:
 sec. 24 T 6 N R 14 E
8 miles west of Paragould
 (distance) (direction) (nearest town)

WELL PURPOSE: Home
 (home, irrigation, municipal, industrial)

- WELL COMPLETION DATA:
- (1) diameter (inches) 2 in.
 - (2) total depth (feet) 321 feet
 - (3) static water level (feet) 100 below/above top of ground.
 - (4) casing galv. 321
 (material) (depth)
 (size) if telescope see back.
 - (5) screen 2x5 321
 (length) (depth to top)
2x6 stainless steel
 (size) (material)
 - (6) pump 70
 (HP) (yield gpm)
 (type power)
 - (7) electric log (yes or no)
 - (organization running log)

CODÉD


(8) how well bottom plugged and remarks

DRILLERS REMARKS: Big Rocks

SEP 21 1972

If well telescopes please sketch and show depths.

GROUND LEVEL

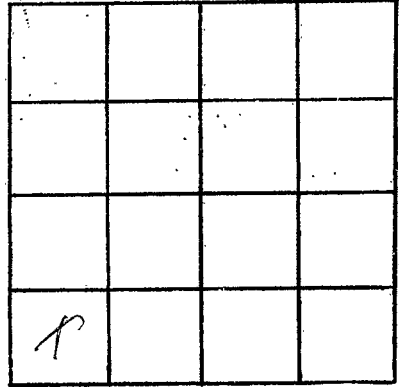

SECTION _____

Please indicate well location X.

ADDITIONAL INFORMATION

If more than one screen, show locations of each on sketch.