

PEARL RIVER
W 117
9-2-72

MISSISSIPPI
BOARD OF WATER COMMISSIONERS
416 North State Street
Jackson, Mississippi 39201

CODED

WATER WELL DRILLERS LOG

9/2 1972 Bud Penton & Son Pearl River
date well completed firm name county well located

LANDOWNER: Dorward
Watkins
B.T. & P. Pearson
(mailing address)

description of formations encountered	from	to
white shale	0	8
white sand	8	16
blue shale	16	240
blue sand	240	300

WELL LOCATION:
sec. 5 T. 26 N. R. 18 E.
5 miles N.W. of Pearson
(distance) (direction) (nearest town)

WELL PURPOSE: none
(home, irrigation, municipal, industrial)

WELL COMPLETION DATA:
(1) diameter (inches) 2 in
(2) total depth (feet) 300
(3) static water level (feet) 23 below top of ground.
(4) casing galv. 294
(material) (depth)
(size) if telescope see back.
(5) screen 2x5 294
(length) (depth to top)
2x5 stainless steel
(size) (material)
(6) pump 1/2 450
(HP) (yield gpm)
Elect
(type power)
(7) electric log no
(yes or no)
(organization running log)

CODED


(8) how well bottom plugged sand sharp

SEP 21 1972

DRILLERS REMARKS:
sand sharp

If well telescopes, please sketch and show depths.

GROUND LEVEL

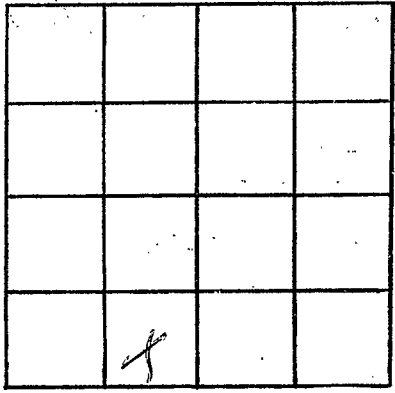

SECTION _____

Please indicate well location X.

ADDITIONAL INFORMATION

If more than one screen, show locations of each on sketch.